City of Prince George
HISTORY SHEET

SHEET NUMBER 010233946

Roll Number 013138570

Legal: LOT'S 1-2 BLOCK D.L. 1476 PLAN 20035

Address: 2617 - 2619 OAK STREET

Sanitary Connection: # 7161 / 7228 SIZE 100mm / 100mm MATERIAL INV. 566.656 / 566.665 CONNECTED

Water Connection # 7169 / 7228 SIZE 20mm/20mm MATERIAL CU METER CONNECTED

Storm Connection: # SIZE MATERIAL INV. CONNECTED

Cash Receipt No's: WATER - 468 SANITARY 388 - 467 STORM

CURB FROM PROPERTY LINE PAVEMENT WIDTH

B.C. HYDRO UNDERGROUND CONNECTION

B.C. TELEPHONE UNDERGROUND CONNECTION

INLAND GAS

Information Sheets:

Comments:
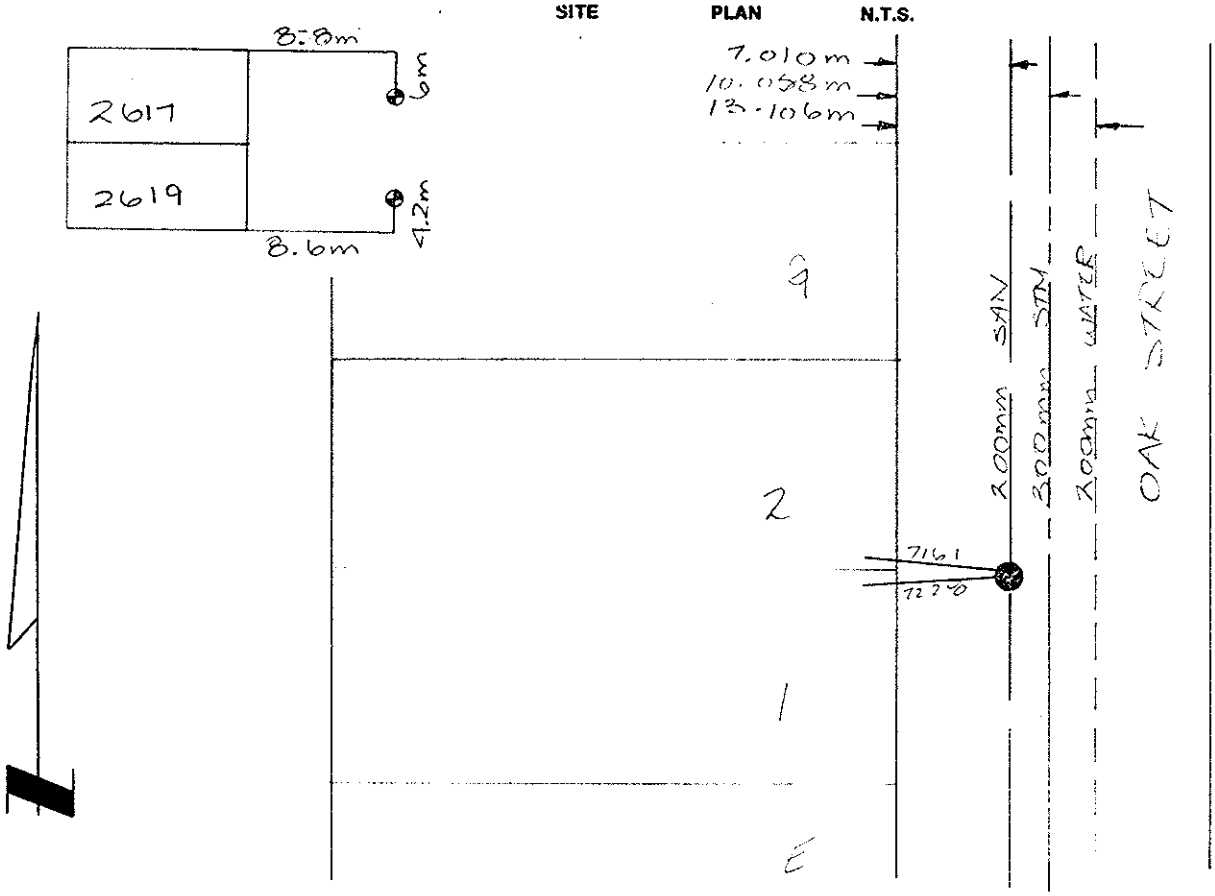
SITE PLAN N.T.S.