City of Prince George
HISTORY SHEET

SHEET NUMBER **3950** **Roll Number** 010236848

Legal: LOT'S 50 BLOCK D.L. 2608 PLAN 26049

Address: 1043 HERITAGE CR.

Sanitary Connection: # SIZE 100 mm ϕ MATERIAL WHITE P.V.C. INV. 604.54 CONNECTED

Water Connection # SIZE 19mm ϕ MATERIAL COPPER METER CONNECTED

Storm Connection: # N/A SIZE MATERIAL INV. CONNECTED

Cash Receipt No's: WATER SANITARY STORM

CURB FROM PROPERTY LINE 5.0 M PAVEMENT WIDTH

B.C. HYDRO UNDERGROUND CONNECTION U/G

B.C. TELEPHONE UNDERGROUND CONNECTION U/G

INLAND GAS

Information Sheets:

Comments: CITY OF P.G. B.M. #975 H.S. S.E. COR. TABOR BLVD & McDERMID DR. ELEV. 608.403
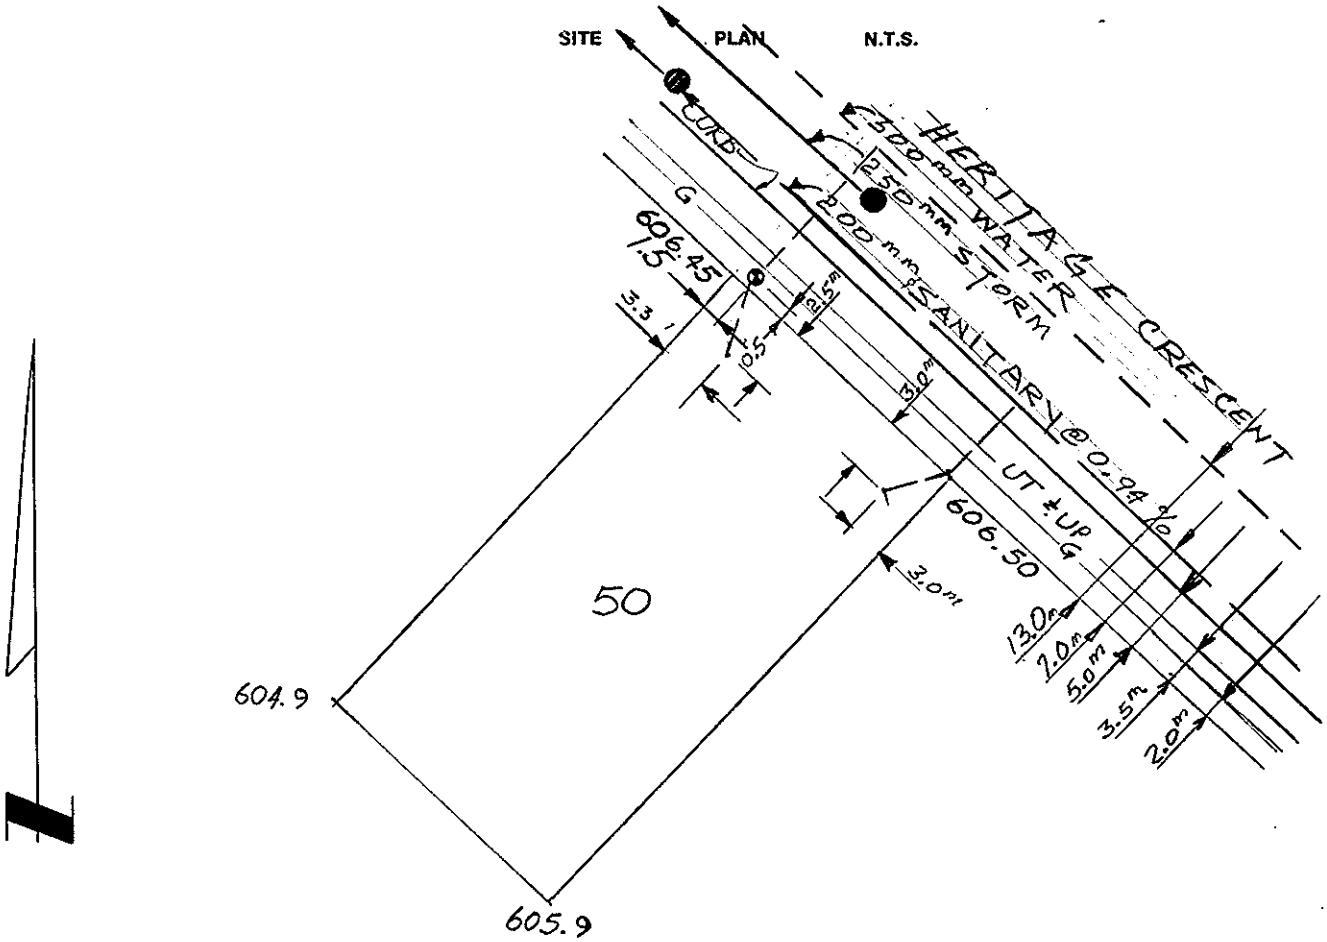
SITE PLAN N.T.S.