City of Prince George
HISTORY SHEET

010326 464

SHEET NUMBER **Roll Number**

Legal: LOT'S 30 BLOCK D.L. 913 PLAN 19932

Address: 2924 - 2928 UPLAND STREET

Sanitary Connection: # 7716 SIZE 100mm MATERIAL A.C. INV. CONNECTED

Water Connection # 7738 SIZE 20mm MATERIAL Cu METER CONNECTED

Storm Connection: # SIZE MATERIAL INV. CONNECTED

Cash Receipt No's: WATER SANITARY STORM

CURB FROM PROPERTY LINE PAVEMENT WIDTH

B.C. HYDRO OVERHEAD UNDERGROUND CONNECTION

B.C. TELEPHONE OVERHEAD UNDERGROUND CONNECTION

INLAND GAS AS SHOWN

Information Sheets:

Comments:
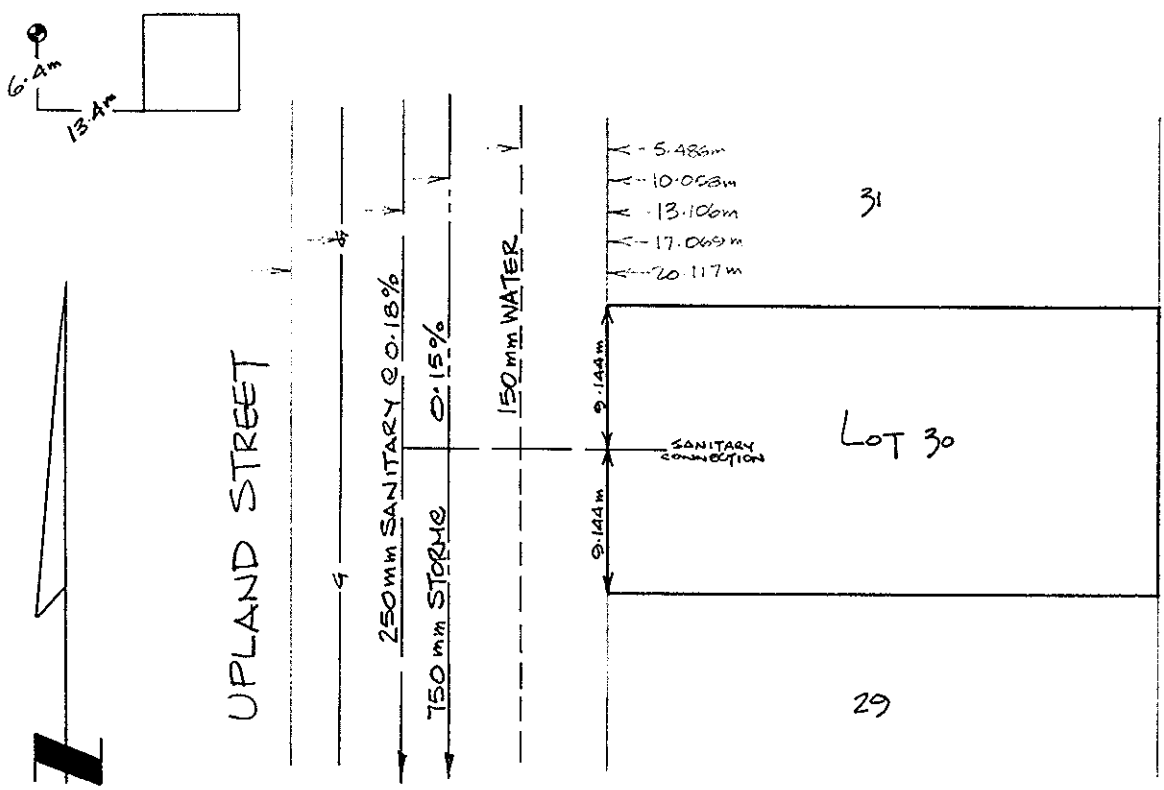
SITE PLAN N.T.S.