City of Prince George
HISTORY SHEET

SHEET NUMBER **Roll Number** 010439269

Legal: LOT'S 91 BLOCK — D.L. 2608 PLAN 19520

Address: 277 BELLOS ST

Sanitary Connection: # 7382 SIZE 100mm MATERIAL A.C. INV. CONNECTED

Water Connection # 7382 SIZE 20mm MATERIAL Cu METER CONNECTED

Storm Connection: # SIZE MATERIAL INV. CONNECTED

Cash Receipt No's: WATER SANITARY STORM

CURB FROM PROPERTY LINE 4.877 m PAVEMENT WIDTH 10.363m

B.C. HYDRO U/G UNDERGROUND CONNECTION

B.C. TELEPHONE U/G UNDERGROUND CONNECTION

INLAND GAS AS SHOWN

Information Sheets:

Comments: WITH THAW WIRE;
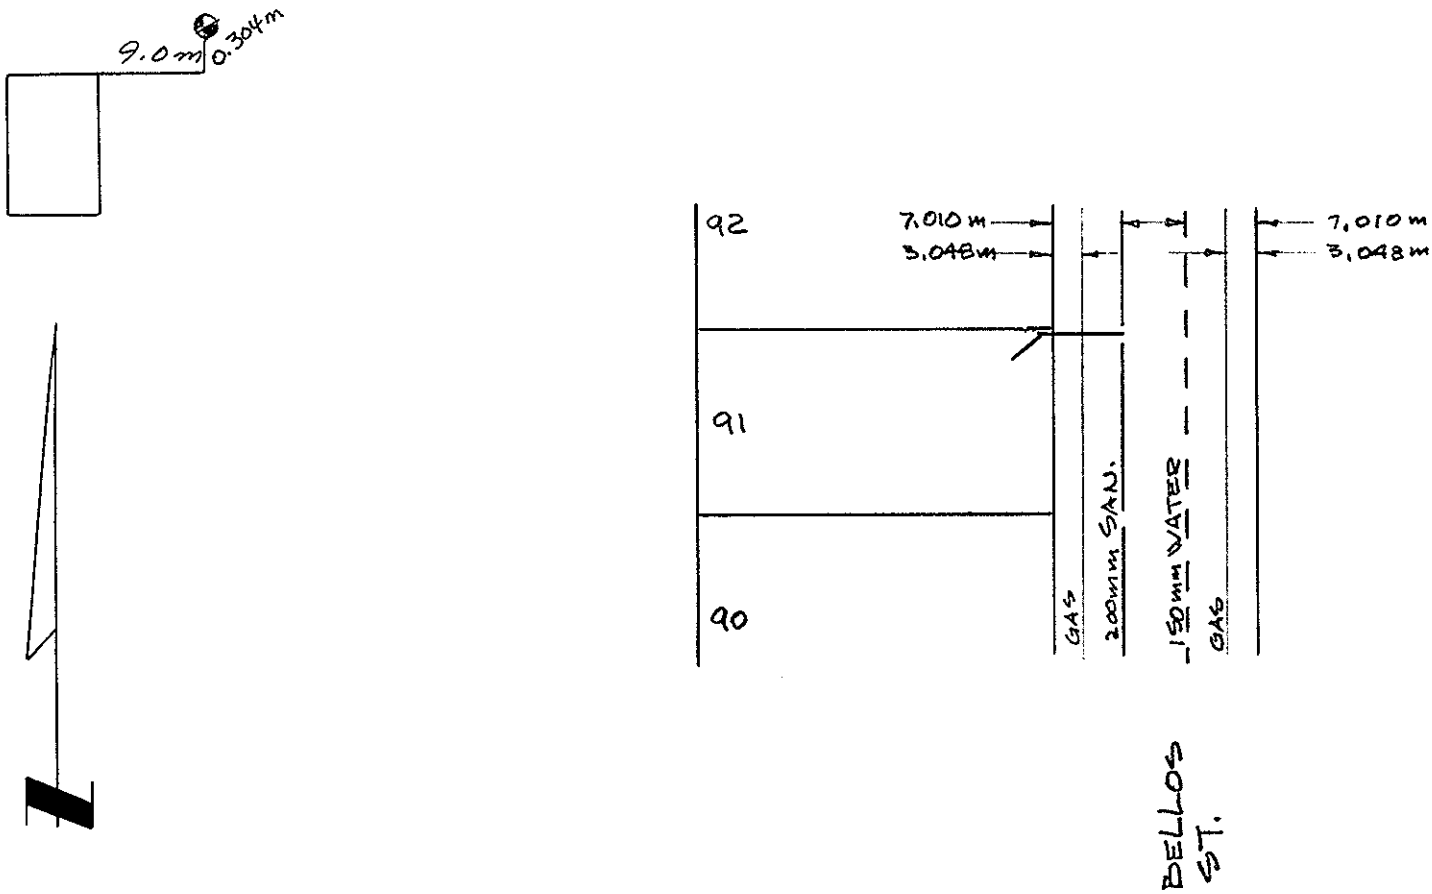
THE INFORMATION CONTAINED HEREIN IS FOR INTERNAL USE ONLY.
NOT TO BE RELIED UPON UNLESS CONFIRMED BY SITE INSPECTION AND/OR INVESTIGATION