City of Prince George
HISTORY SHEET

SHEET NUMBER **Roll Number** 3 10 740 038

Legal: LOT'S 100 BLOCK D.L. 2608 PLAN 19520

Address: 256 CLARK CRES.

Sanitary Connection: # 7391 SIZE 100 mm MATERIAL A.C INV. CONNECTED YES

Water Connection # 7391 SIZE 20 mm MATERIAL copper METER CONNECTED YES

Storm Connection: # SIZE MATERIAL INV. CONNECTED

Cash Receipt No's: WATER SANITARY STORM

CURB FROM PROPERTY LINE PAVEMENT WIDTH

B.C. HYDRO UNDERGROUND CONNECTION

B.C. TELEPHONE UNDERGROUND CONNECTION

INLAND GAS

Information Sheets:
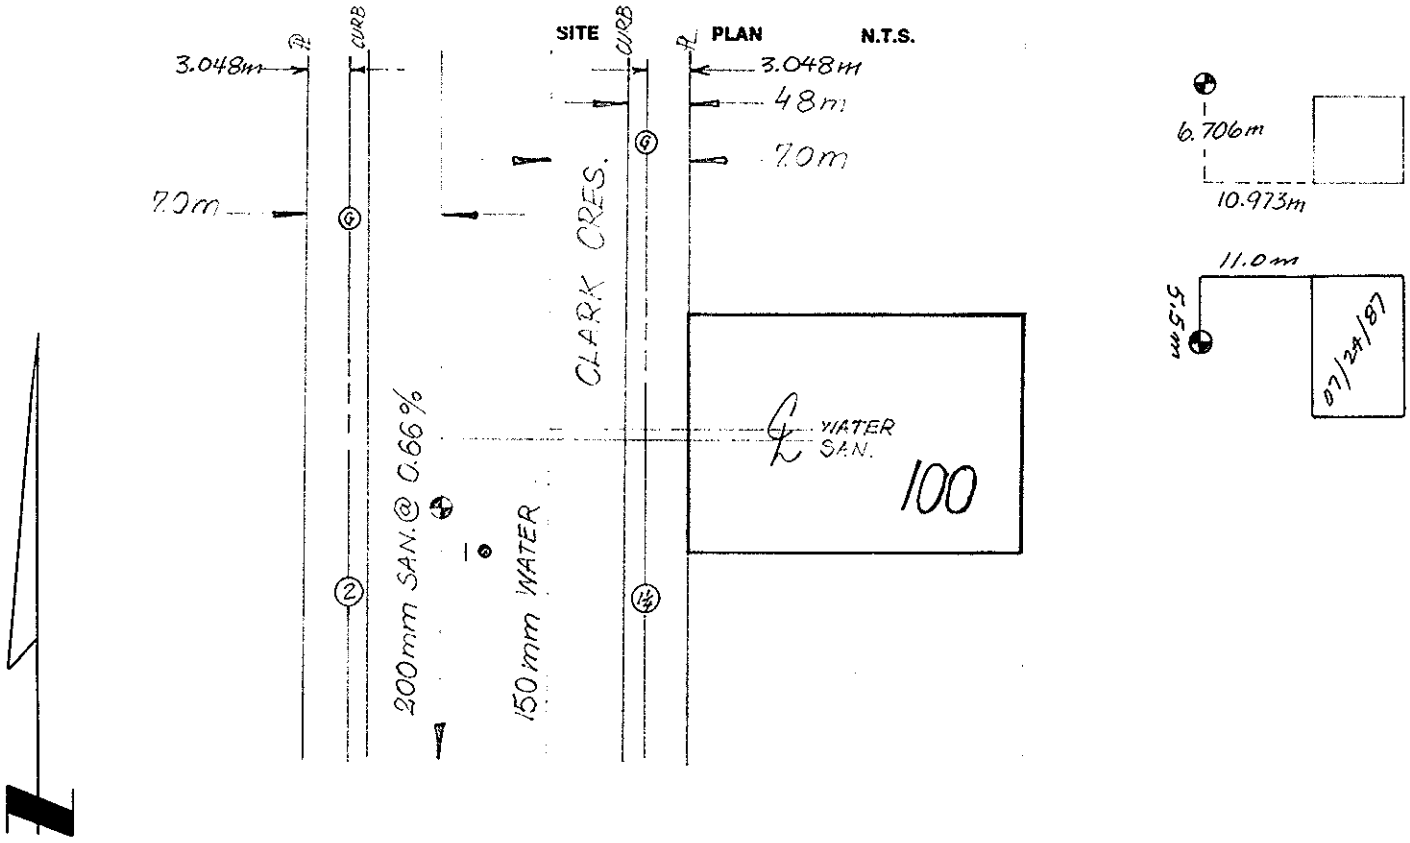
Comments: