City of Prince George
HISTORY SHEET

SHEET NUMBER № 2642 **Roll Number** 010449451

Legal: LOT'S B BLOCK D.L. 753 PLAN 16758

Address: 4019 HOLLANDIA DR

Sanitary Connection: # 12695 SIZE 4" MATERIAL INV. CONNECTED

Water Connection # 12695 SIZE 3/4" MATERIAL METER CONNECTED

Storm Connection: # SIZE MATERIAL INV. CONNECTED

Cash Receipt No's: WATER SANITARY STORM

CURB FROM PROPERTY LINE PAVEMENT WIDTH

B.C. HYDRO OVERHEAD UNDERGROUND CONNECTION

B.C. TELEPHONE OVERHEAD UNDERGROUND CONNECTION

INLAND GAS NO GAS

Information Sheets:

Comments:

THE INFORMATION CONTAINED HEREIN IS FOR INTERNAL USE ONLY. NOT TO BE RELIED UPON UNLESS CONFIRMED BY SITE INSPECTION AND/OR INVESTIGATION.
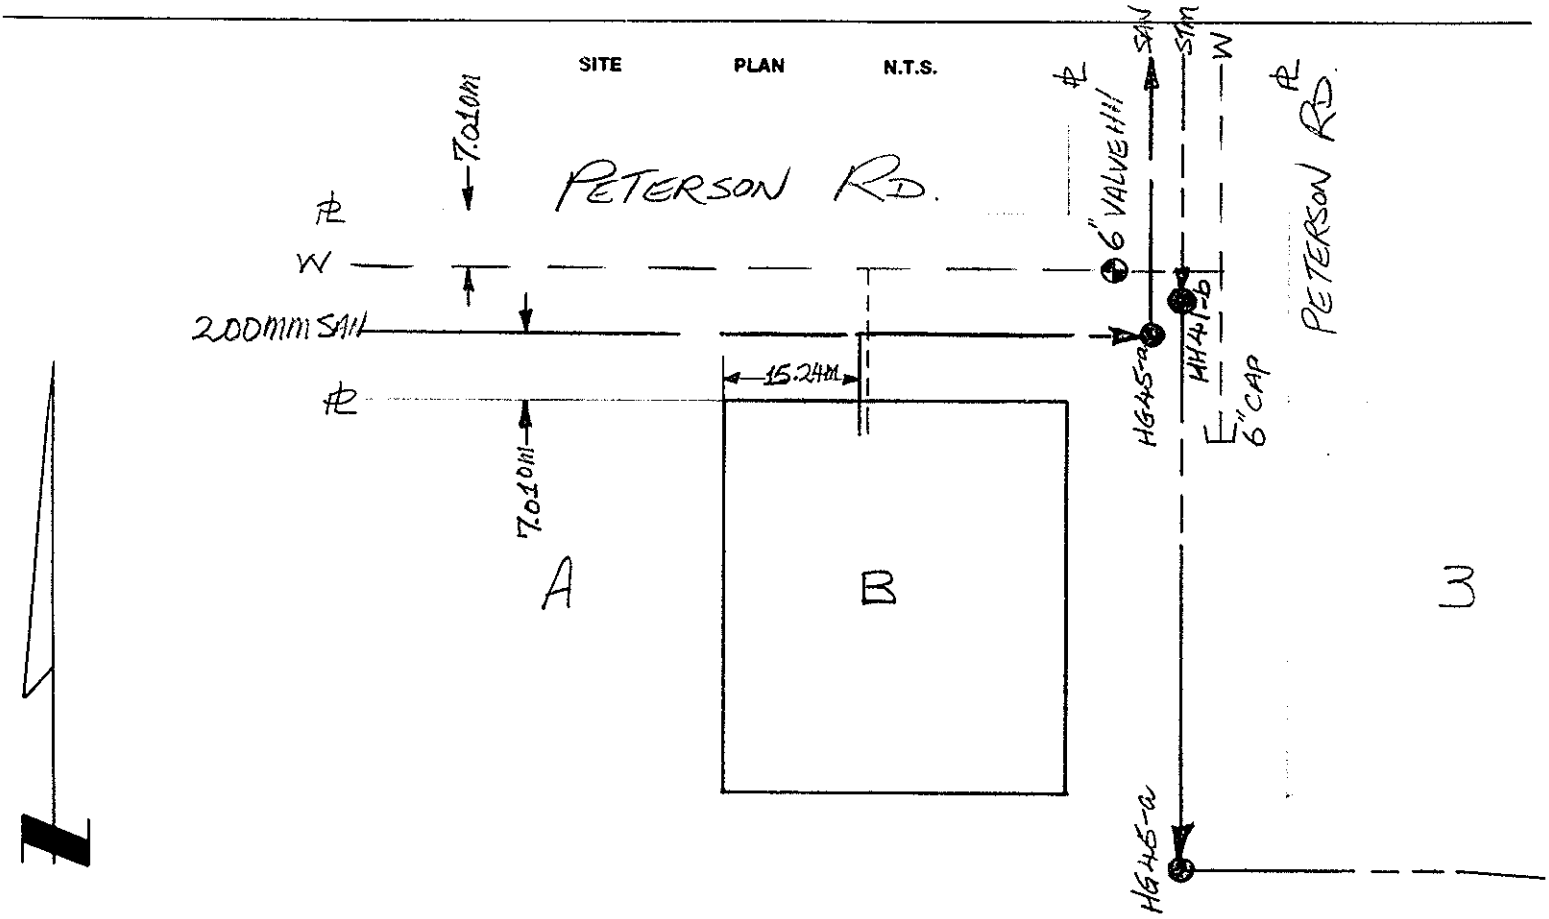
SITE PLAN N.T.S.