City of Prince George
HISTORY SHEET

SHEET NUMBER ~~Roll~~ Number 010480056

Legal: LOT'S 21 BLOCK D.L. 8171 PLAN 19517

Address: 2540 BYNG AVE.

Sanitary Connection: # 7454 SIZE 100mm MATERIAL A.C. INV. CONNECTED

Water Connection # 7454 SIZE 20mm MATERIAL CU. METER CONNECTED

Storm Connection: # SIZE MATERIAL INV. CONNECTED

Cash Receipt No's: WATER SANITARY STORM

CURB FROM PROPERTY LINE 4.877 m PAVEMENT WIDTH 10.363 m

B.C. HYDRO U/G UNDERGROUND CONNECTION

B.C. TELEPHONE U/G UNDERGROUND CONNECTION

INLAND GAS AS SHOWN

Information Sheets:

Comments: WITH THAW WIRE
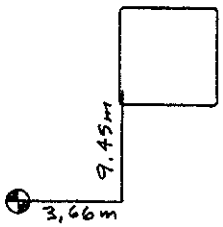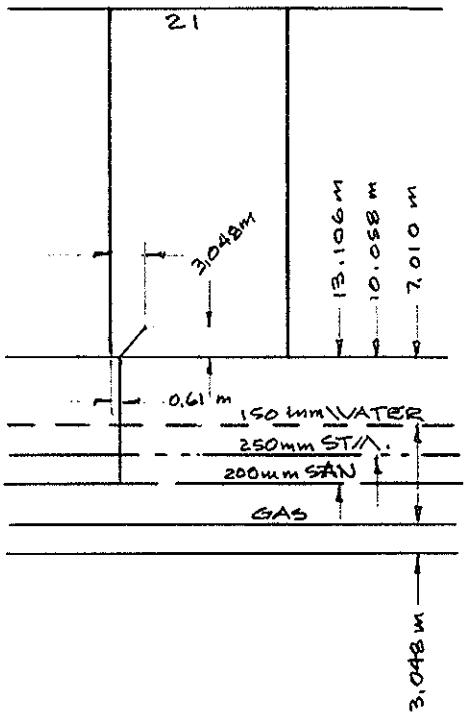
THE INFORMATION CONTAINED HEREIN IS FOR INTERNAL USE ONLY.
NOT TO BE RELIED UPON UNLESS CONFIRMED BY SITE INSPECTION AND/OR INVESTIGATION