City of Prince George
HISTORY SHEET

SHEET NUMBER **PID #** 010-530-762

Legal: LOT'S 18 BLOCK 1 D.L. 8178 PLAN 16808

Address: 118 FERN CRES.

Sanitary Connection: # 6198 SIZE 100 mm MATERIAL A.C. INV. 586.970 CONNECTED

Water Connection: # 6198 SIZE 20 mm MATERIAL CU. METER CONNECTED

Storm Connection: # SIZE mm MATERIAL INV. CONNECTED

Cash Receipt No's: WATER SANITARY STORM

CURB FROM PROPERTY LINE 4.877 m PAVEMENT WIDTH 10.363 m

B.C. HYDRO 0.914 m FROM PL. UNDERGROUND CONNECTION

B.C. TELEPHONE 0.914 m FROM PL. UNDERGROUND CONNECTION

INLAND GAS 3.048 m FROM SOUTH SIDE OF FERN.

Information Sheets:

Comments: WITH THAW WIRE.
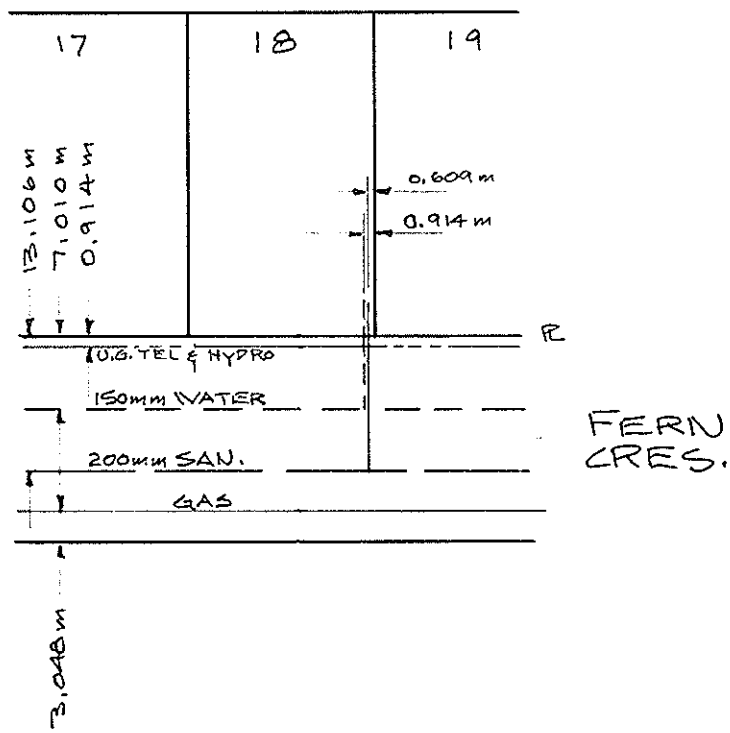
THE INFORMATION CONTAINED HEREIN IS FOR INTERNAL USE ONLY.
NOT TO BE RELIED UPON UNLESS CONFIRMED BY SITE INSPECTION AND/OR INVESTIGATION