City of Prince George
HISTORY SHEET

SHEET NUMBER **Roll Number** 01061571

Legal: LOT'S 22 BLOCK D.L. 1427 PLAN 19099

Address: 107 PARKER DRIVE

Sanitary Connection: # 6905 SIZE 100 mm MATERIAL AC INV. CONNECTED

Water Connection # 6905 SIZE 20 mm MATERIAL Cu. METER CONNECTED

Storm Connection: # SIZE MATERIAL INV. CONNECTED

Cash Receipt No's: WATER SANITARY STORM

CURB FROM PROPERTY LINE PAVEMENT WIDTH

B.C. HYDRO UNDERGROUND CONNECTION

B.C. TELEPHONE UNDERGROUND CONNECTION

INLAND GAS

Information Sheets:
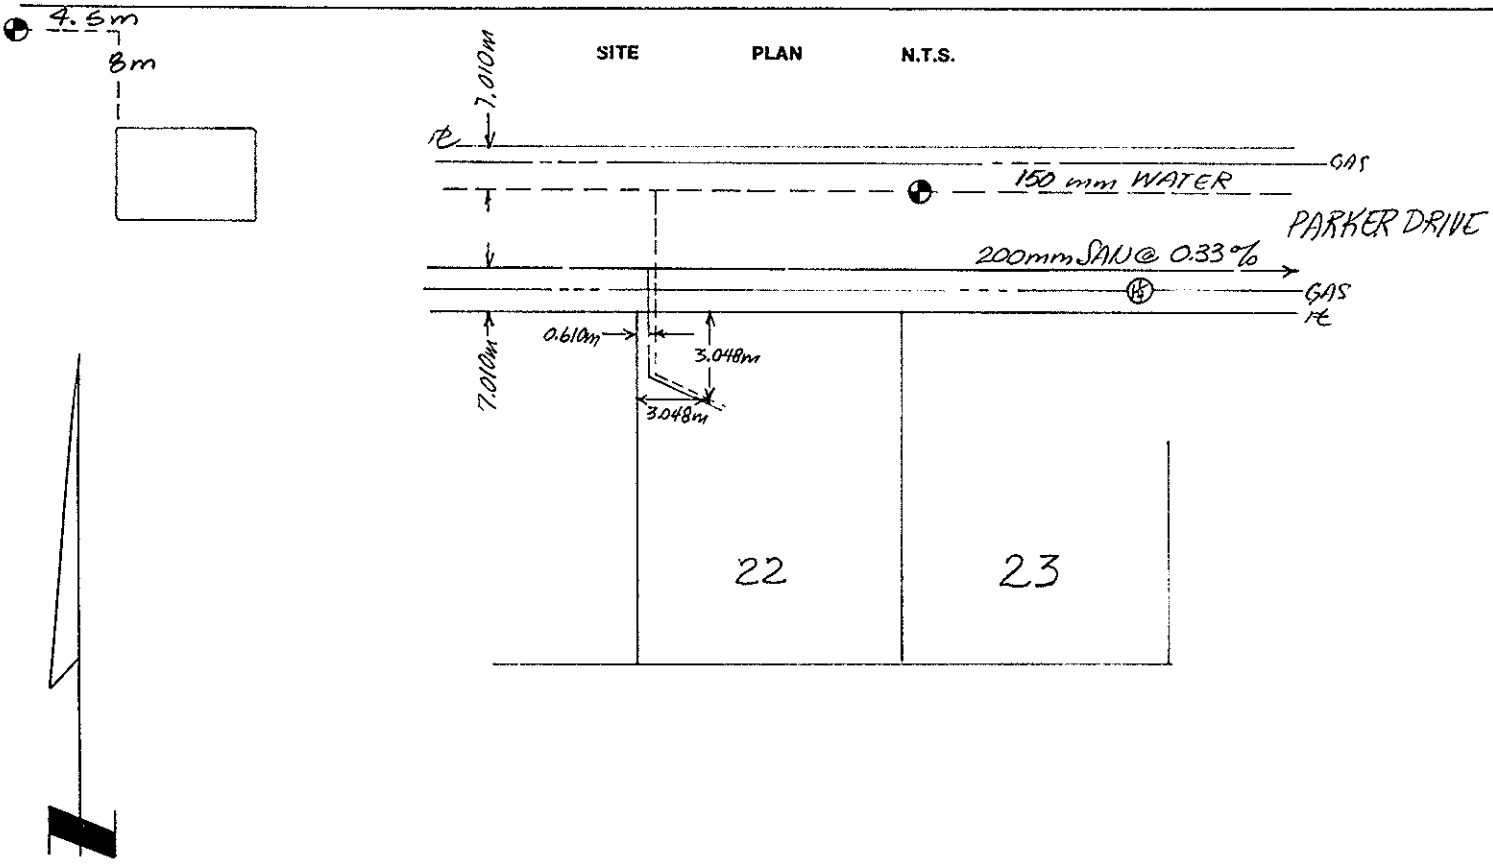
Comments: All connection information supplied by Associated Engineering Services Ltd