City of Prince George
HISTORY SHEET

SHEET NUMBER 10534 **Roll Number** 010626794

Legal: LOT'S D BLOCK D.L. 2433 PLAN 17232

Address: 4112 KNIGHT RD.

Sanitary Connection: # SIZE 100MM MATERIAL PVC. INV. CONNECTED

Water Connection # SIZE 3/4" MATERIAL Cu METER CONNECTED

Storm Connection: # SIZE MATERIAL INV. CONNECTED

Cash Receipt No's: WATER SANITARY 7843 STORM

CURB FROM PROPERTY LINE PAVEMENT WIDTH

B.C. HYDRO UNDERGROUND CONNECTION

B.C. TELEPHONE UNDERGROUND CONNECTION

INLAND GAS

Information Sheets:

Comments: N/O WATER SERVICE: 5' WEST OF EAST or PROP LINE
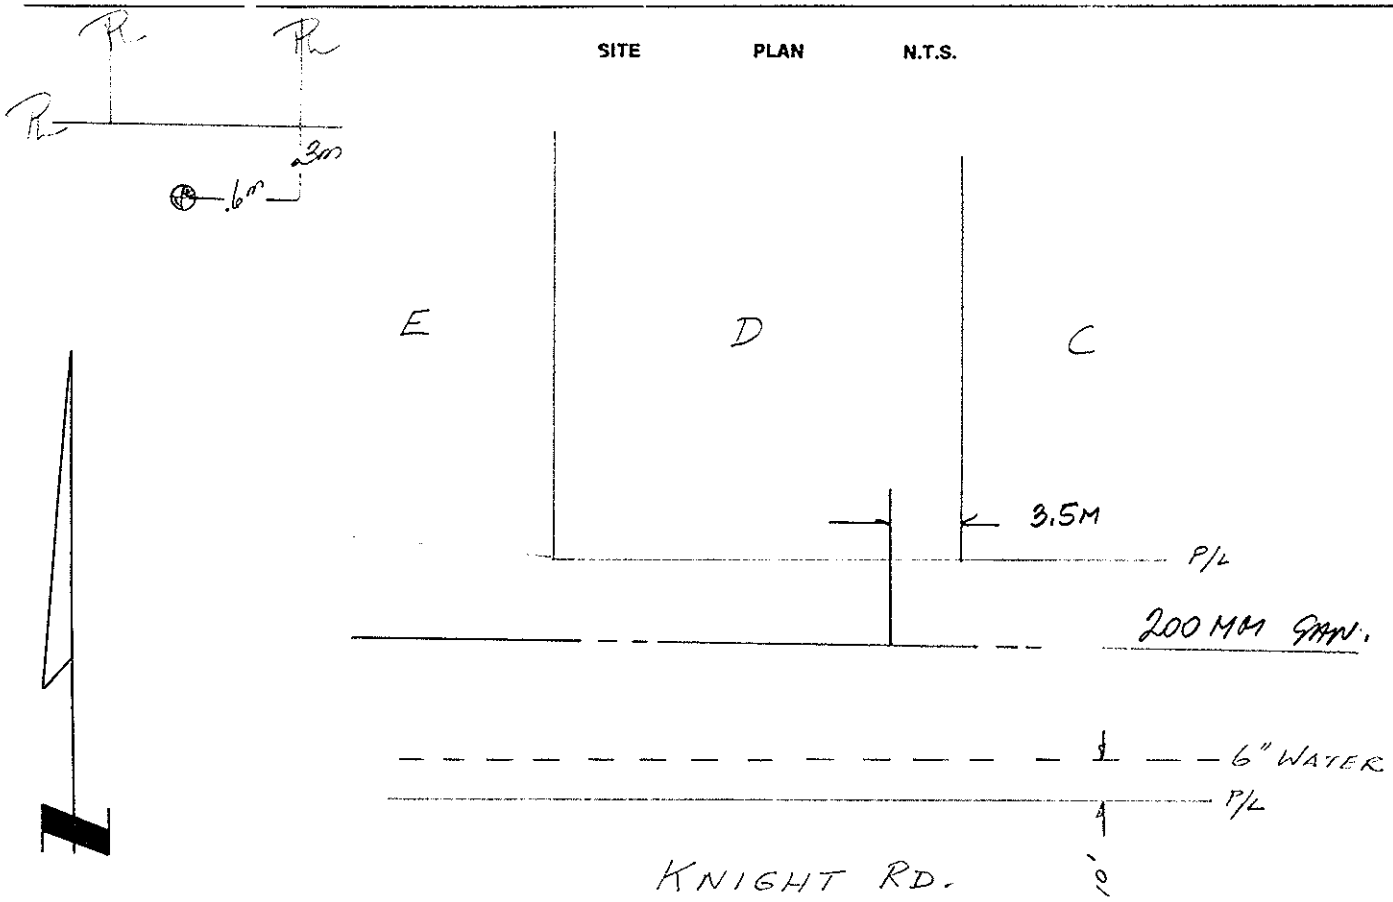
SITE PLAN N.T.S.