City of Prince George
HISTORY SHEET

01063/038

SHEET NUMBER 6823 **Roll Number**

Legal: LOT'S 21 BLOCK D.L. 4047 PLAN 19038

Address: 6059 BIRCHWOOD CRESCENT

Sanitary Connection: # 12400 SIZE [illegible] MATERIAL INV. 723.185 CONNECTED

Water Connection # SIZE 3/4" MATERIAL Copper METER CONNECTED

Storm Connection: # SIZE MATERIAL INV. CONNECTED

Cash Receipt No's: WATER SANITARY 2342 STORM

CURB FROM PROPERTY LINE PAVEMENT WIDTH

B.C. HYDRO O.H. UNDERGROUND CONNECTION

B.C. TELEPHONE O.H. UNDERGROUND CONNECTION

INLAND GAS AS SHOWN.

Information Sheets:

Comments:

OWNER: STEVENS ALLEN FREDERICK & IRENE MARY ANNE
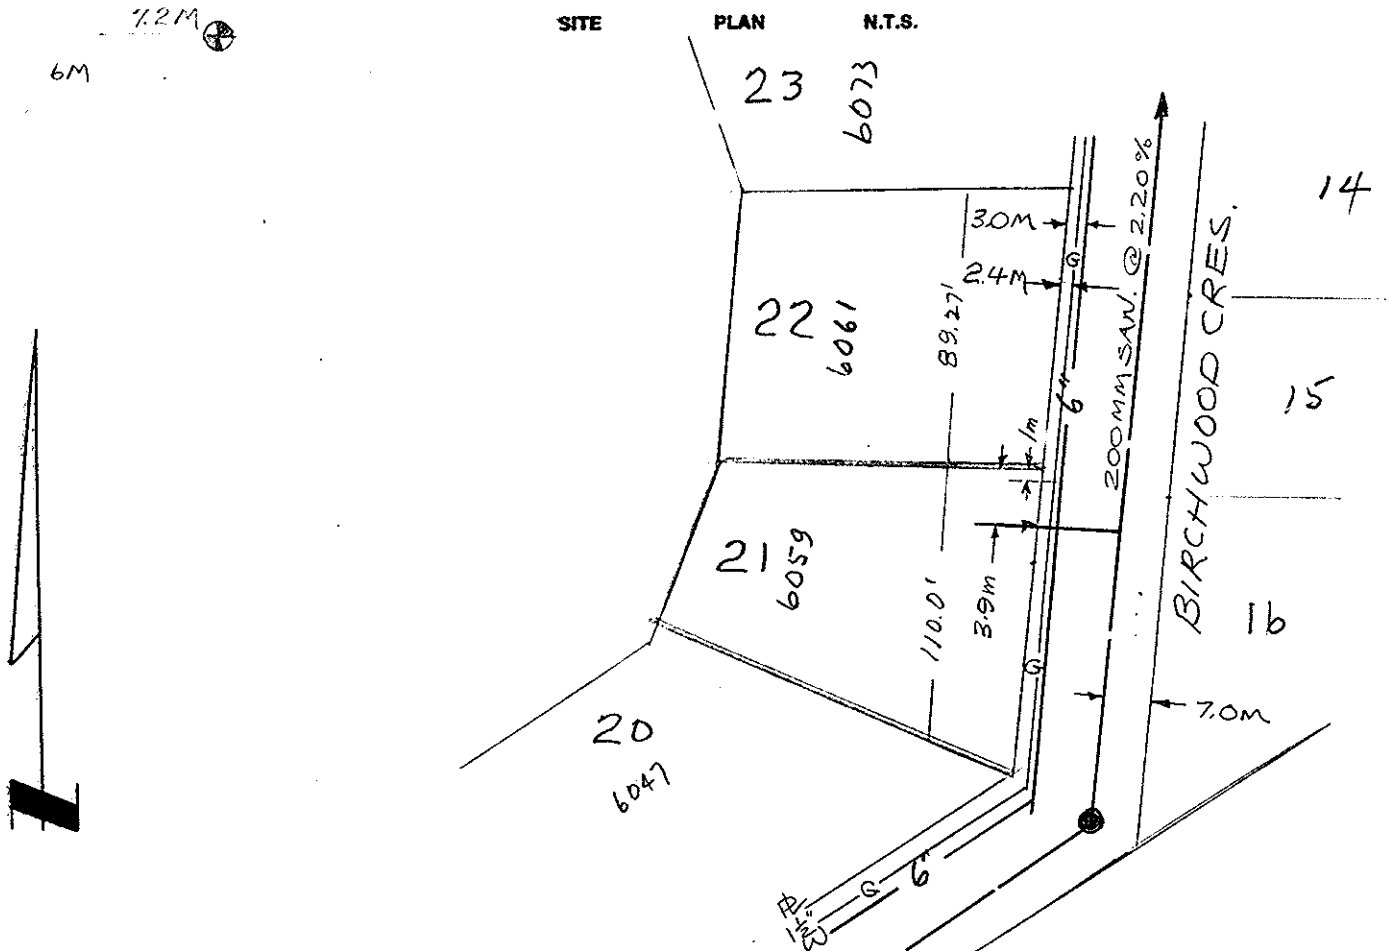
SITE PLAN N.T.S.