City of Prince George
HISTORY SHEET

B10631275

SHEET NUMBER 6804 Roll Number

Legal: LOT'S: 2 BLOCK: D.L. 4047 PLAN 19038

Address: 6186 BIRCHWOOD CRESCENT

Sanitary Connection: # 12567 SIZE 4" MATERIAL INV. 715.409 CONNECTED

Water Connection # SIZE 3/4" MATERIAL Copper METER CONNECTED

Storm Connection: # SIZE MATERIAL INV. CONNECTED

Cash Receipt No's: WATER SANITARY 2420 STORM

CURB FROM PROPERTY LINE PAVEMENT WIDTH

B.C. HYDRO O.H. UNDERGROUND CONNECTION

B.C. TELEPHONE O.H. UNDERGROUND CONNECTION

INLAND GAS AS SHOWN

Information Sheets:

Comments:
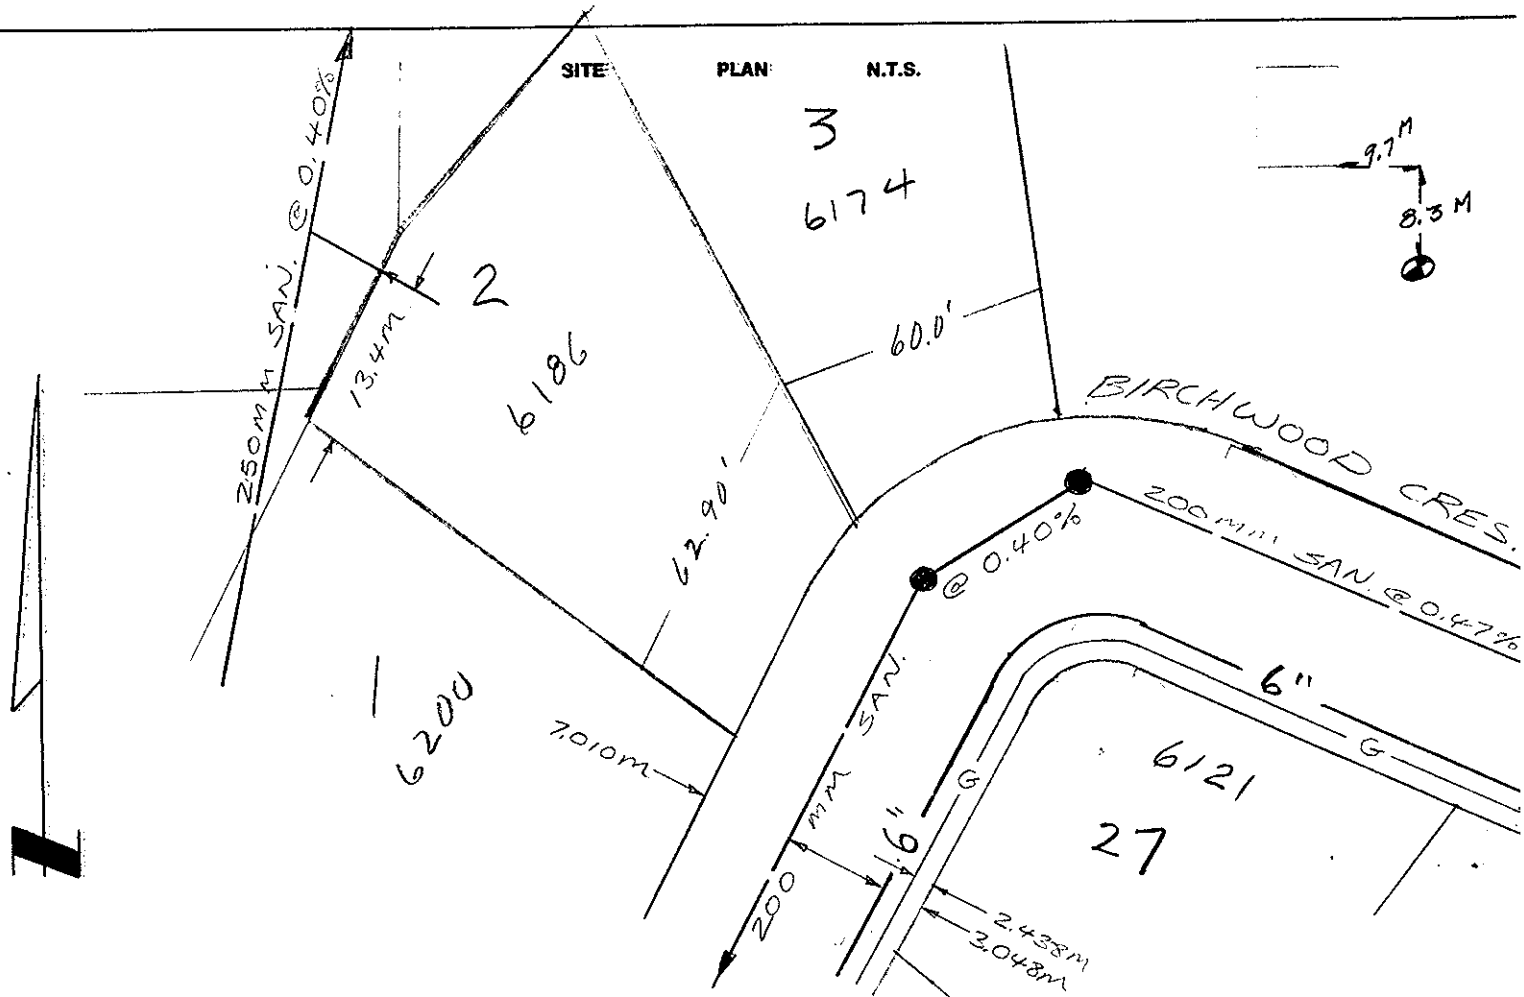
OWNER: McLEOD BARY RUSSELL & LINDA JEANNE