010736107
010736115

City of Prince George
HISTORY SHEET

SHEET NUMBER № 2126 **Roll Number**

Legal: LOT'S 19, 20 BLOCK 330 D.L. 343 PLAN 1268

Address: 1918 VINE STREET

Sanitary Connection: # 6747 SIZE 4" MATERIAL A.C. INV. CONNECTED

Water Connection # 720 SIZE ½" MATERIAL COPPER METER CONNECTED

Storm Connection: # SIZE MATERIAL INV. CONNECTED

Cash Receipt No's: WATER SANITARY 276 STORM

CURB FROM PROPERTY LINE PAVEMENT WIDTH

B.C. HYDRO UNDERGROUND CONNECTION

B.C. TELEPHONE UNDERGROUND CONNECTION

INLAND GAS

Information Sheets:

Comments:
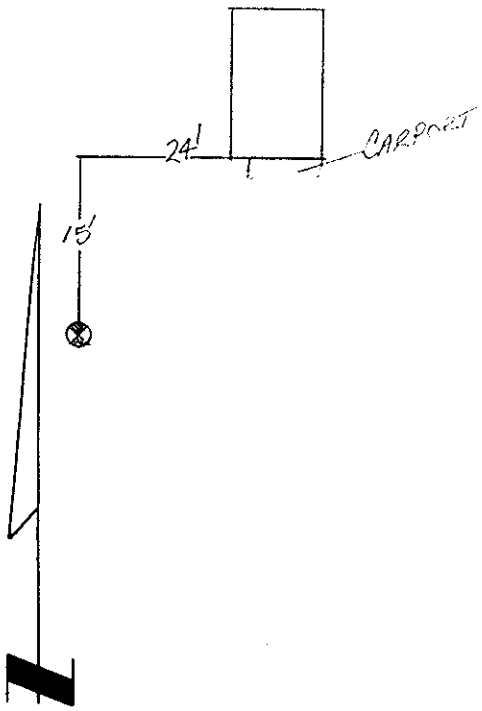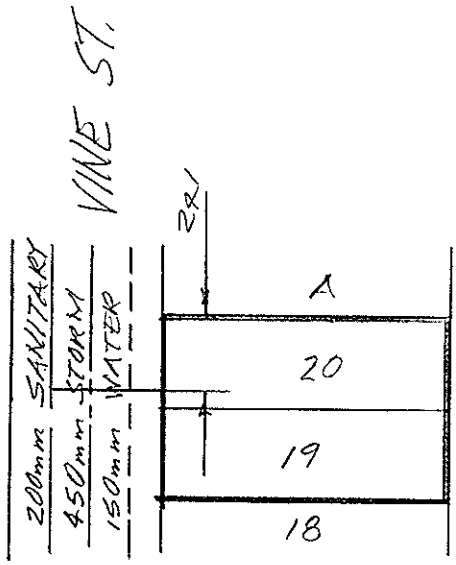
SITE PLAN N.T.S.