City of Prince George
HISTORY SHEET

SHEET NUMBER **Roll Number** 010740279

Legal: LOT'S 23 BLOCK D.L. 8172 PLAN 18944

Address: 2505 LORNE CRES.

Sanitary Connection: # 6831 SIZE 100mm MATERIAL A.C. INV. CONNECTED 1970

Water Connection # 6831 SIZE 20mm MATERIAL CO. METER CONNECTED 1970

Storm Connection: # SIZE MATERIAL INV. CONNECTED

Cash Receipt No's: WATER SANITARY STORM

CURB FROM PROPERTY LINE 4.877 PAVEMENT WIDTH 10.363

B.C. HYDRO AS SHOW UNDERGROUND CONNECTION

B.C. TELEPHONE " UNDERGROUND CONNECTION

INLAND GAS "

Information Sheets:

Comments: WITH THAW WIRE
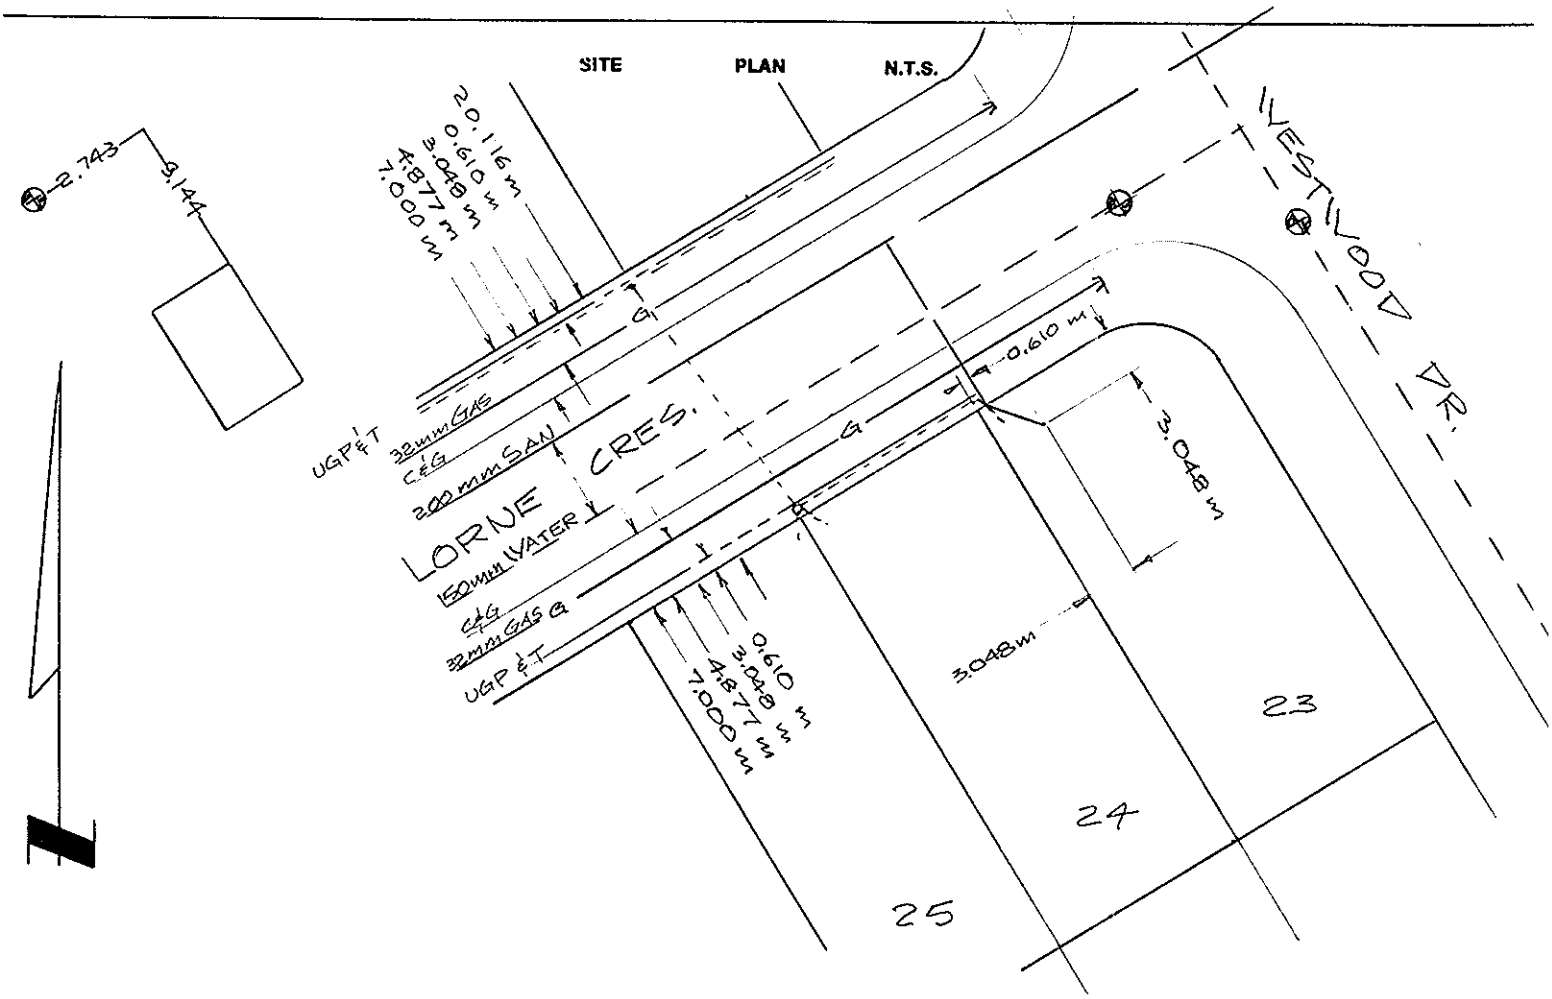
SITE PLAN N.T.S.