City of Prince George
HISTORY SHEET

SHEET NUMBER **Roll Number** 010740465

Legal: LOT'S 65 BLOCK D.L. 8172 PLAN 18944

Address: 2417 LISGAR CRES.

Sanitary Connection: # 6873 SIZE 100 mm MATERIAL AC. INV. CONNECTED 1970

Water Connection # 6873 SIZE 20 mm MATERIAL CO. METER CONNECTED 1970

Storm Connection: # SIZE MATERIAL INV. CONNECTED

Cash Receipt No's: WATER SANITARY STORM

CURB FROM PROPERTY LINE 4.877 m PAVEMENT WIDTH 10.362 m

B.C. HYDRO AS SHOWN UNDERGROUND CONNECTION

B.C. TELEPHONE " UNDERGROUND CONNECTION

INLAND GAS "

Information Sheets:

Comments: WITH THAW WIRE

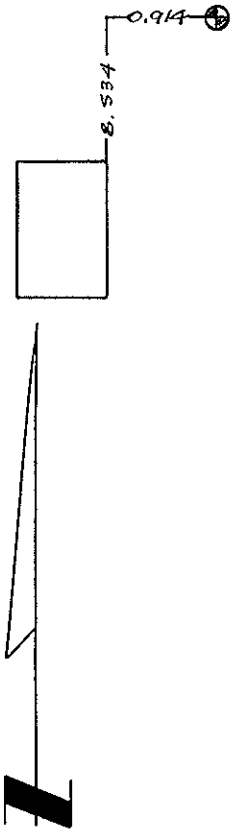
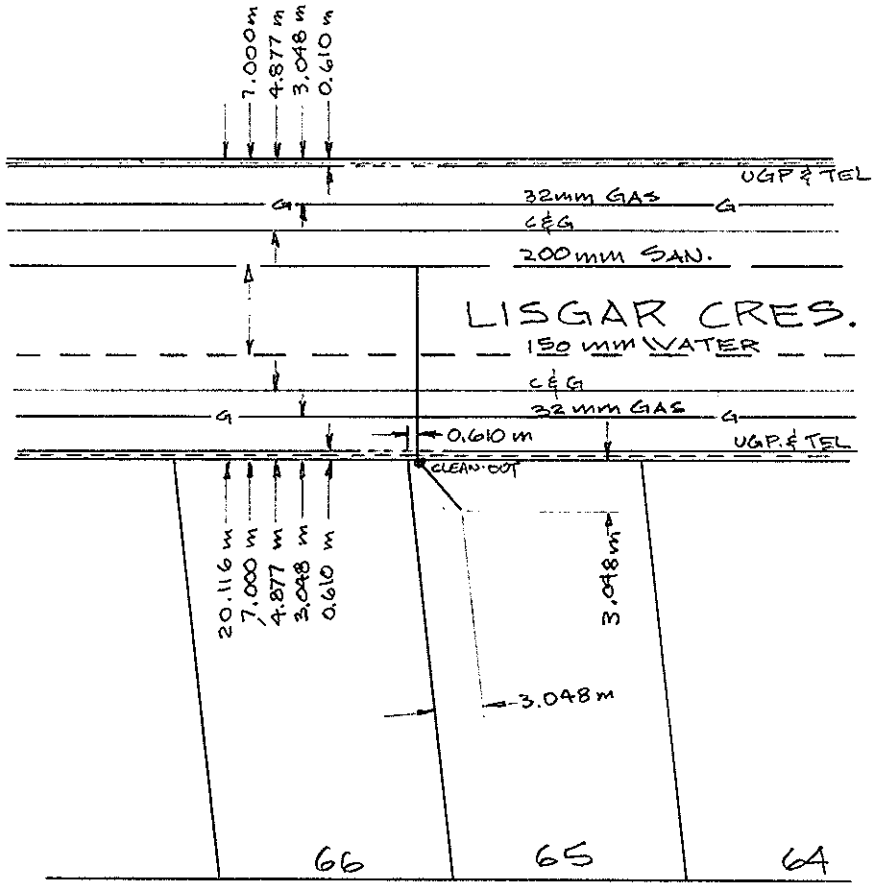
SITE PLAN N.T.S.