City of Prince George
HISTORY SHEET

010769 790

SHEET NUMBER 6801 **Roll Number**

Legal: LOT'S G BLOCK D.L. 4047 PLAN ~~18899~~ 18900

Address: 5930 THERESA PLACE

Sanitary Connection: # SIZE MATERIAL INV. CONNECTED

Water Connection # SIZE 3/4" MATERIAL Copper METER CONNECTED

Storm Connection: # SIZE MATERIAL INV. CONNECTED

Cash Receipt No's: WATER SANITARY STORM

CURB FROM PROPERTY LINE PAVEMENT WIDTH

B.C. HYDRO UNDERGROUND CONNECTION

B.C. TELEPHONE UNDERGROUND CONNECTION

INLAND GAS

Information Sheets:

Comments: NID WATER SERVICE - 4' SOUTH OF POWER POLE ON NE CORNER

OWNER: RANDALL Raymond Stuart & Elizabeth Mae 1-7-75
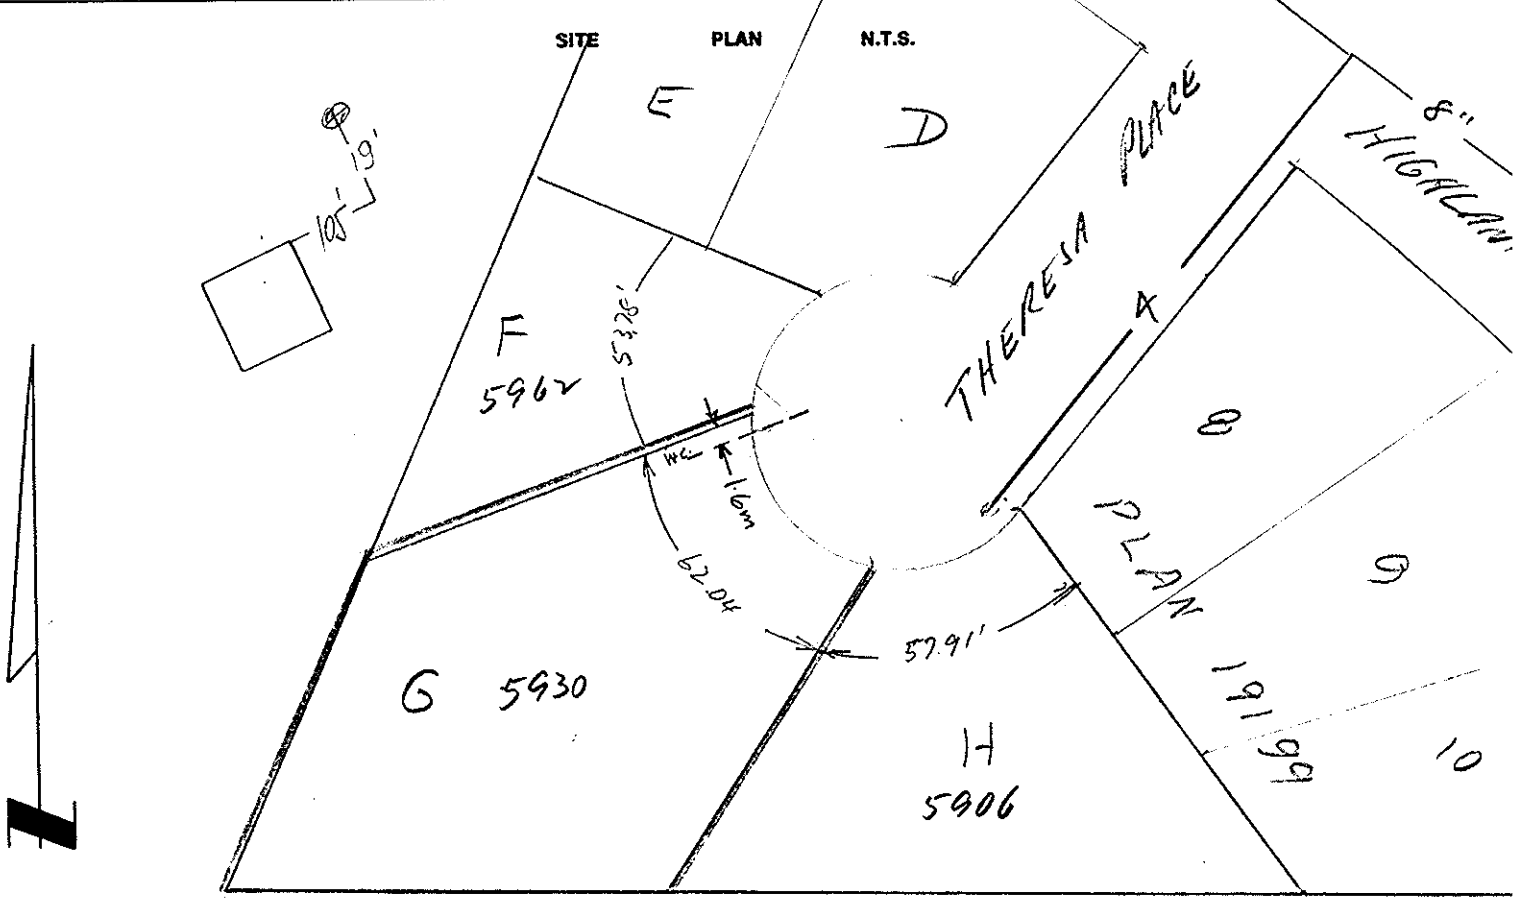
SITE PLAN N.T.S.