010771 531
549

S

City of Prince George
HISTORY SHEET

SHEET NUMBER № 1302 **Roll Number**

Legal: LOT'S 19, 20 BLOCK 278 D.L. 343 PLAN 1268

Address: 1710 TAMARACK STREET

Sanitary Connection: # 3084 SIZE 100mm MATERIAL TRANSITE INV. CONNECTED

Water Connection # 2348 3228 SIZE 3/4" MATERIAL COPPER METER CONNECTED

Storm Connection: # SIZE MATERIAL INV. CONNECTED

Cash Receipt No's: WATER SANITARY STORM

CURB FROM PROPERTY LINE PAVEMENT WIDTH

B.C. HYDRO UNDERGROUND CONNECTION

B.C. TELEPHONE UNDERGROUND CONNECTION

INLAND GAS

Information Sheets:

Comments:
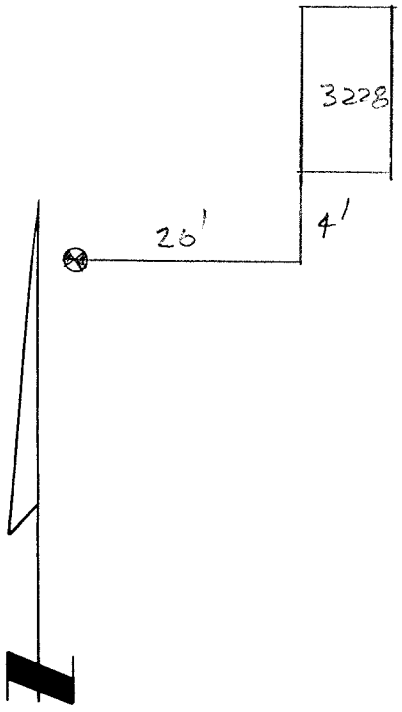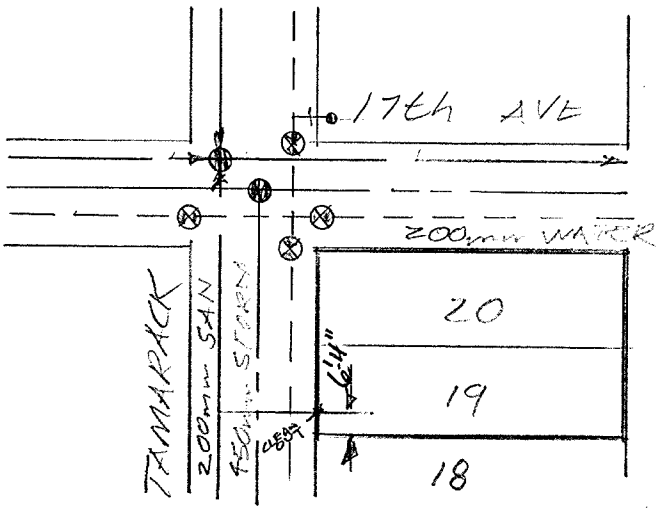
SITE PLAN N.T.S.