City of Prince George
HISTORY SHEET

D5

SHEET NUMBER 7317 **Roll Number** 010809333

Legal: LOT'S 5 BLOCK D.L. 2425 PLAN 13794

Address: 5422 FERGUSON LAKE RD.

Sanitary Connection: # SIZE MATERIAL INV. CONNECTED

Water Connection # SIZE MATERIAL METER CONNECTED

Storm Connection: # SIZE MATERIAL INV. CONNECTED

Cash Receipt No's: WATER SANITARY STORM

CURB FROM PROPERTY LINE PAVEMENT WIDTH

B.C. HYDRO UNDERGROUND CONNECTION

B.C. TELEPHONE UNDERGROUND CONNECTION

INLAND GAS

Information Sheets:

Comments:
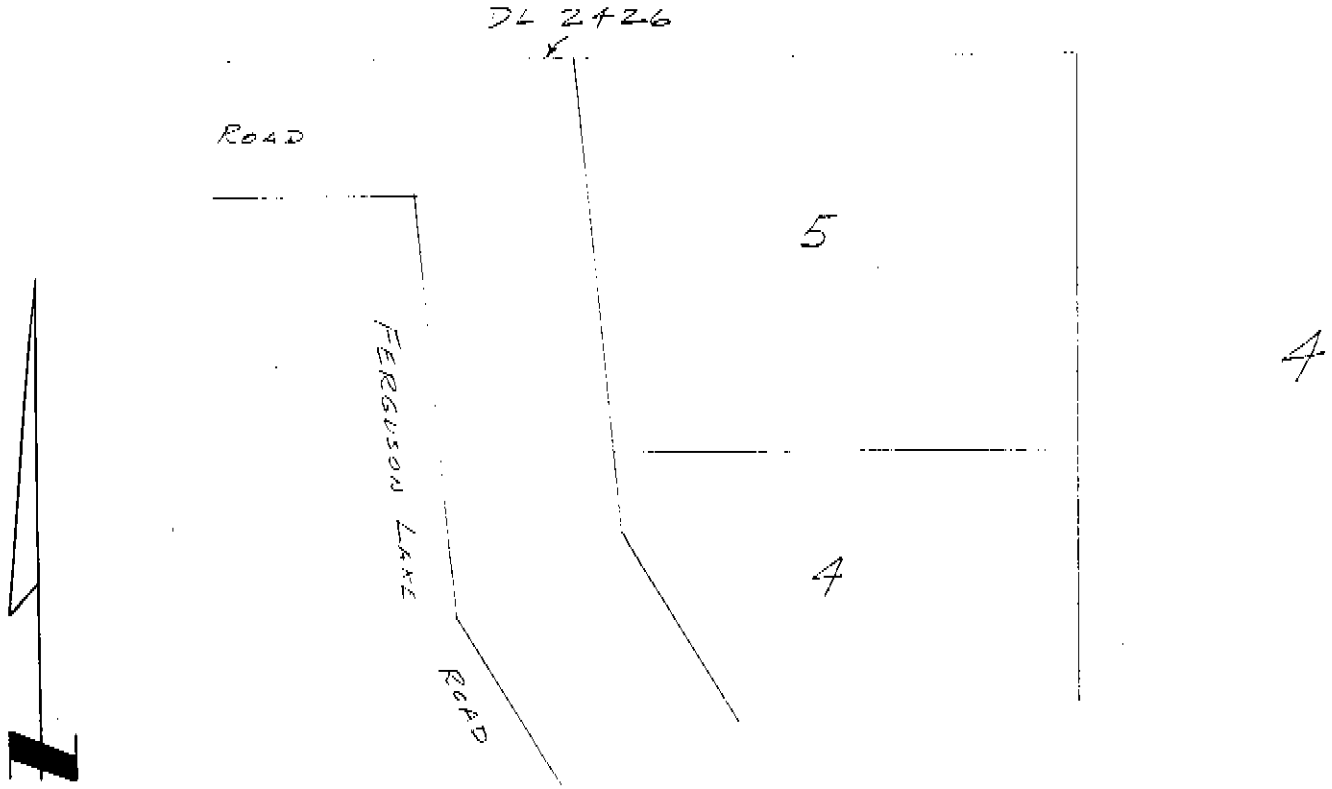
SITE PLAN N.T.S.