City of Prince George
HISTORY SHEET

SHEET NUMBER **Roll Number** 010819916

Legal: LOT'S 54 BLOCK D.L. 8172 PLAN 18944

Address: 2434 LISGAR CRES.

Sanitary Connection: # 6862 SIZE 100mm MATERIAL A.C. INV. CONNECTED 1970

Water Connection # 6862 SIZE 20 mm MATERIAL Co. METER CONNECTED 1970

Storm Connection: # SIZE MATERIAL INV. CONNECTED

Cash Receipt No's: WATER SANITARY STORM

CURB FROM PROPERTY LINE AS SHOWN PAVEMENT WIDTH VARIES

B.C. HYDRO " UNDERGROUND CONNECTION

B.C. TELEPHONE " UNDERGROUND CONNECTION

INLAND GAS "

Information Sheets:

Comments: WITH THAW WIRE
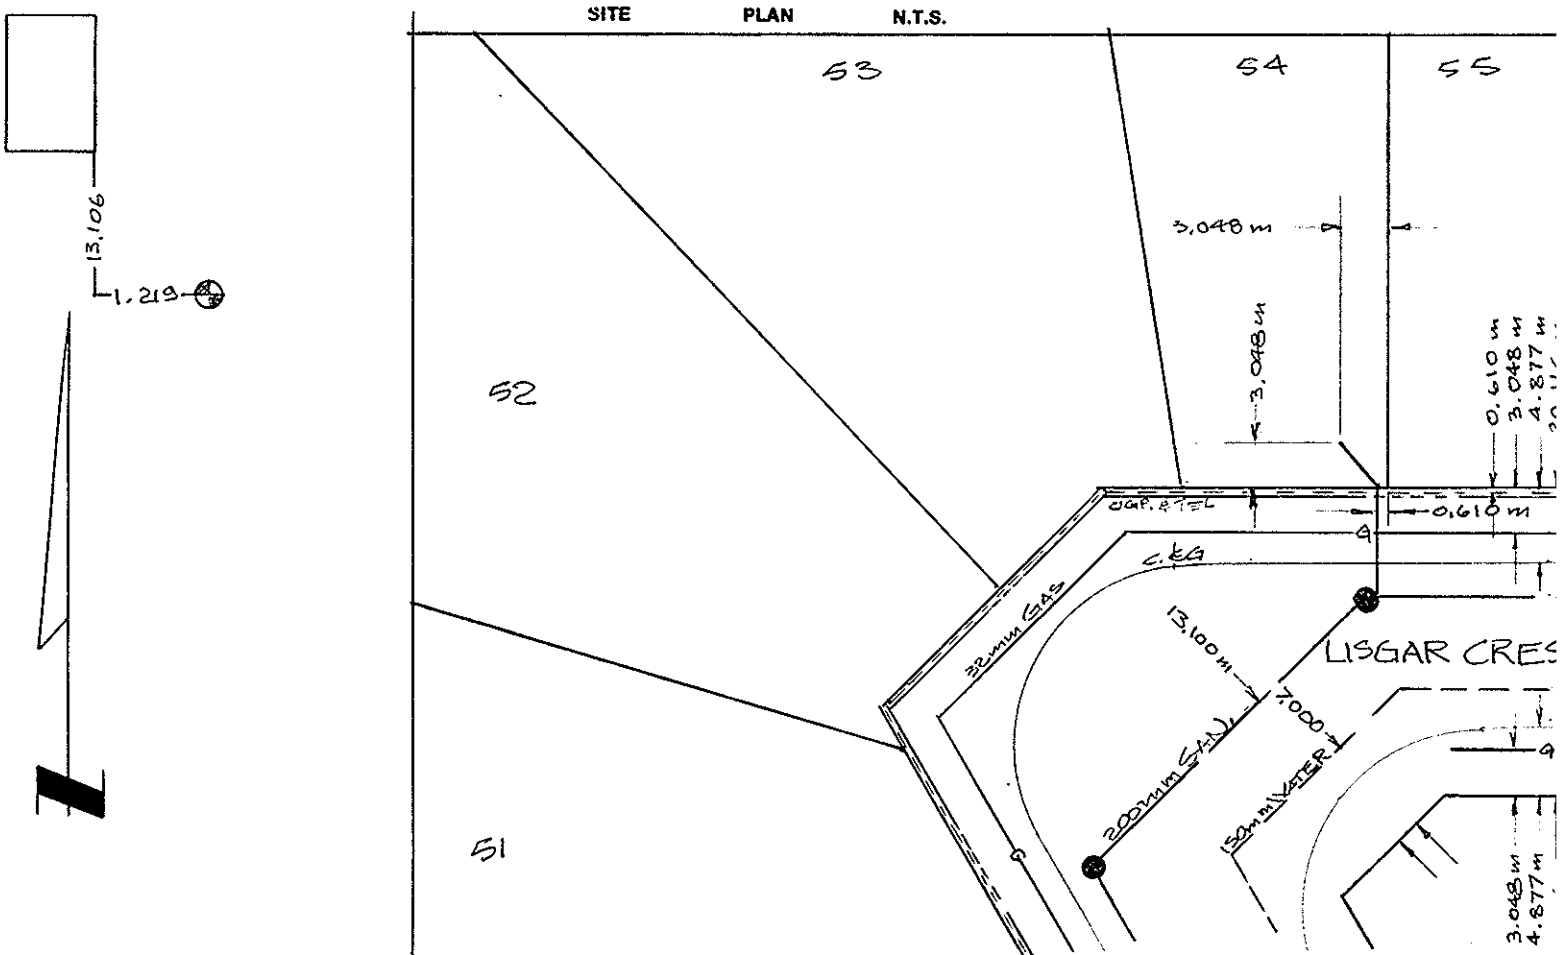
SITE PLAN N.T.S.