City of Prince George
HISTORY SHEET

SHEET NUMBER № 1699 **Roll Number** 010829989

Legal: LOT'S A BLOCK D.L. 937 PLAN 18581

Address: 505 CENTRAL

Sanitary Connection: # 4629 SIZE 100mm MATERIAL ACS INV. CONNECTED

Water Connection # 4255 SIZE 25mm MATERIAL Cu METER CONNECTED

Storm Connection: # 149 SIZE MATERIAL INV. CONNECTED

Cash Receipt No's: WATER SANITARY STORM 2734

CURB FROM PROPERTY LINE PAVEMENT WIDTH

B.C. HYDRO UNDERGROUND CONNECTION

B.C. TELEPHONE UNDERGROUND CONNECTION

INLAND GAS

Information Sheets:
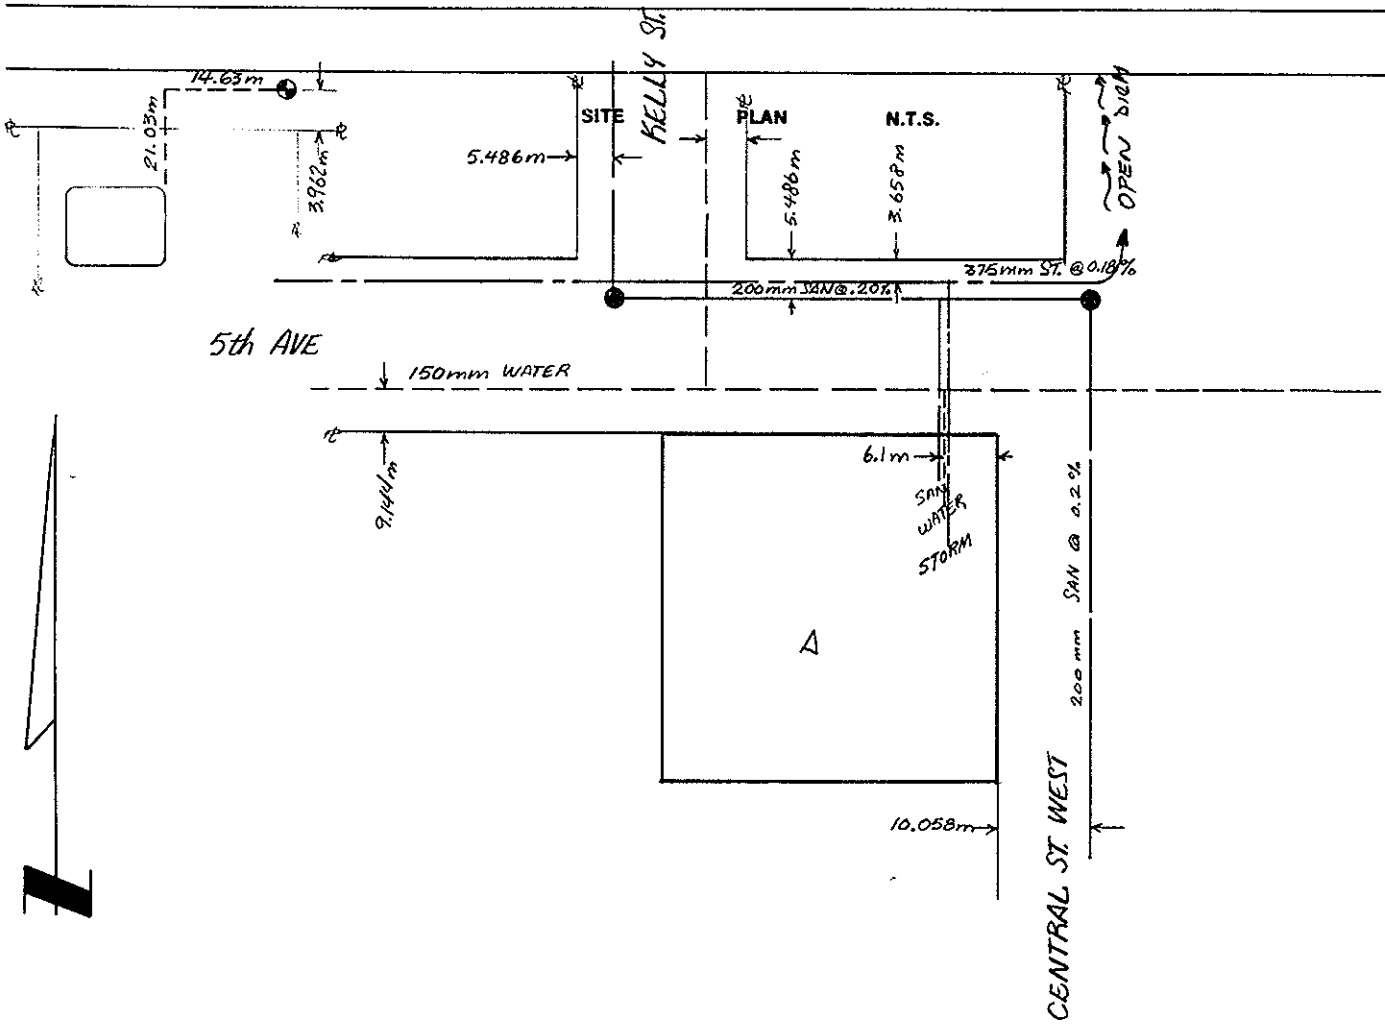
Comments: