01082 9304
01084 9408

City of Prince George
HISTORY SHEET

SHEET NUMBER № 1860 **Roll Number**

Legal: LOT'S 1, 2 BLOCK 312 D.L. 343 PLAN 1268

Address: 1805 NORWOOD STREET

Sanitary Connection: # 557 SIZE MATERIAL INV. CONNECTED

Water Connection # 680 SIZE 1/2" MATERIAL METER CONNECTED

Storm Connection: # SIZE MATERIAL INV. CONNECTED

Cash Receipt No's: WATER SANITARY STORM

CURB FROM PROPERTY LINE PAVEMENT WIDTH

B.C. HYDRO UNDERGROUND CONNECTION

B.C. TELEPHONE UNDERGROUND CONNECTION

INLAND GAS

Information Sheets:

Comments:
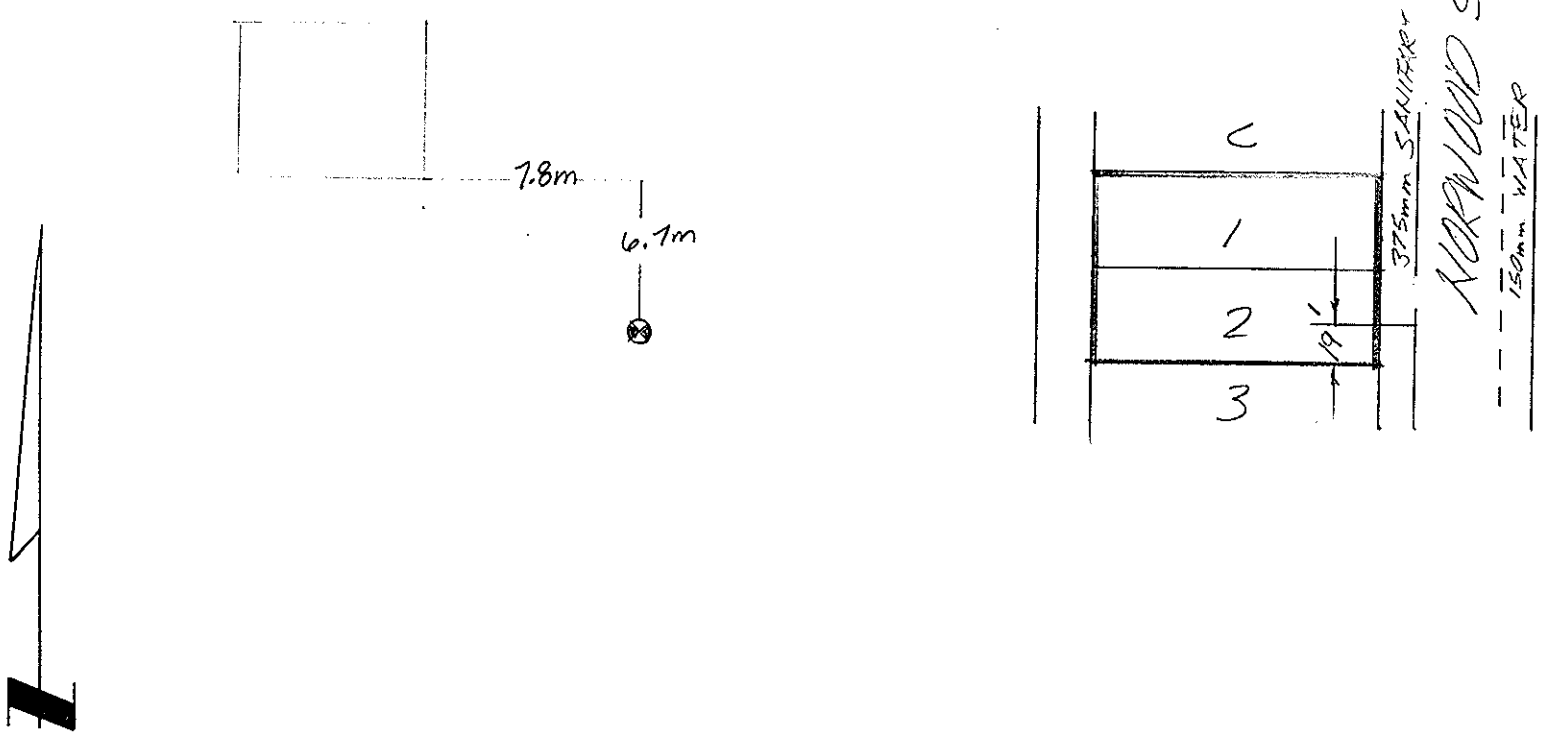
SITE PLAN N.T.S.