City of Prince George
HISTORY SHEET

010876910

SHEET NUMBER 6790 **Roll Number**

Legal: LOT'S 69 BLOCK D.L. 4047 PLAN 18801

Address: 6977 TAFT DRIVE

Sanitary Connection: # 13466 SIZE 100mm MATERIAL P.V.C. INV. 33.973 CONNECTED

Water Connection # SIZE 3/4" MATERIAL Cu METER CONNECTED

Storm Connection: # SIZE MATERIAL INV. CONNECTED

Cash Receipt No's: WATER SANITARY 2660 STORM

CURB FROM PROPERTY LINE PAVEMENT WIDTH

B.C. HYDRO UNDERGROUND CONNECTION

B.C. TELEPHONE UNDERGROUND CONNECTION

INLAND GAS

THE INFORMATION CONTAINED HEREIN IS FOR INTERNAL USE ONLY. NOT TO BE RELIED UPON UNLESS CONFIRMED BY SITE INSPECTION AND/OR INVESTIGATION.

Information Sheets:

Comments: MID WATER SERVICE - 20' NORTH OF SOUTH PL

OWNER: LEE, Robert Darrell & Carole Ann 1-7-75
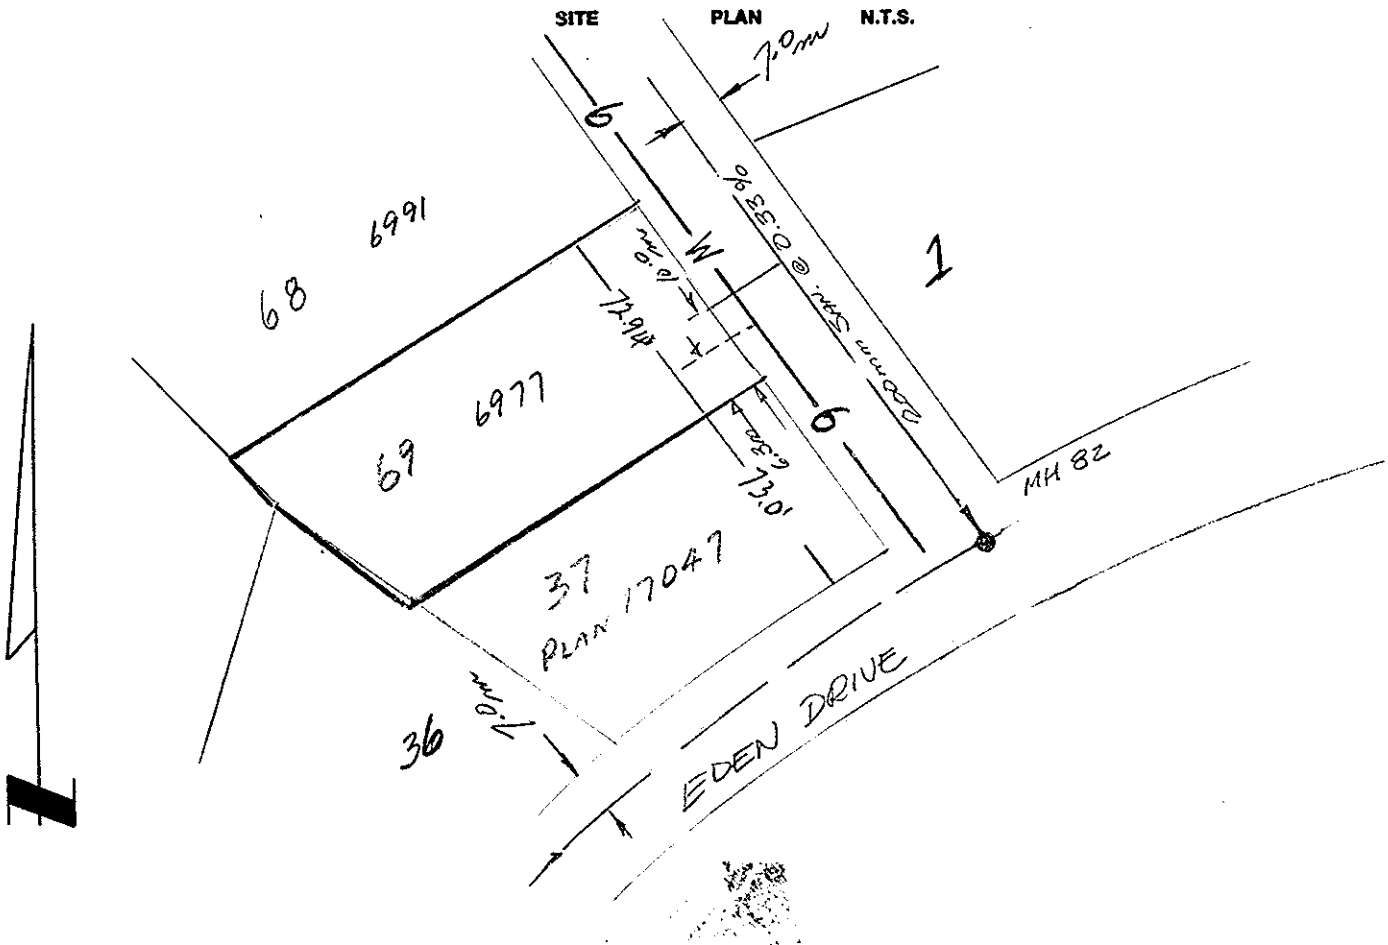
SITE PLAN N.T.S.