City of Prince George
HISTORY SHEET

010878866

SHEET NUMBER **Roll Number**

Legal: LOT'S PARCEL A BLOCK D.L. 4047 PLAN 18801

Address:

Sanitary Connection: # 13476 / 13477 SIZE 100mm/100mm MATERIAL PVC/PVC INV. 33.600/33.900 CONNECTED

Water Connection # SIZE 20mm/20mm MATERIAL METER CONNECTED

Storm Connection: # SIZE MATERIAL INV. CONNECTED

Cash Receipt No's: WATER SANITARY STORM

CURB FROM PROPERTY LINE PAVEMENT WIDTH 8.000m

B.C. HYDRO O/H UNDERGROUND CONNECTION

B.C. TELEPHONE O/H UNDERGROUND CONNECTION

INLAND GAS AS SHOWN

Information Sheets:

Comments:
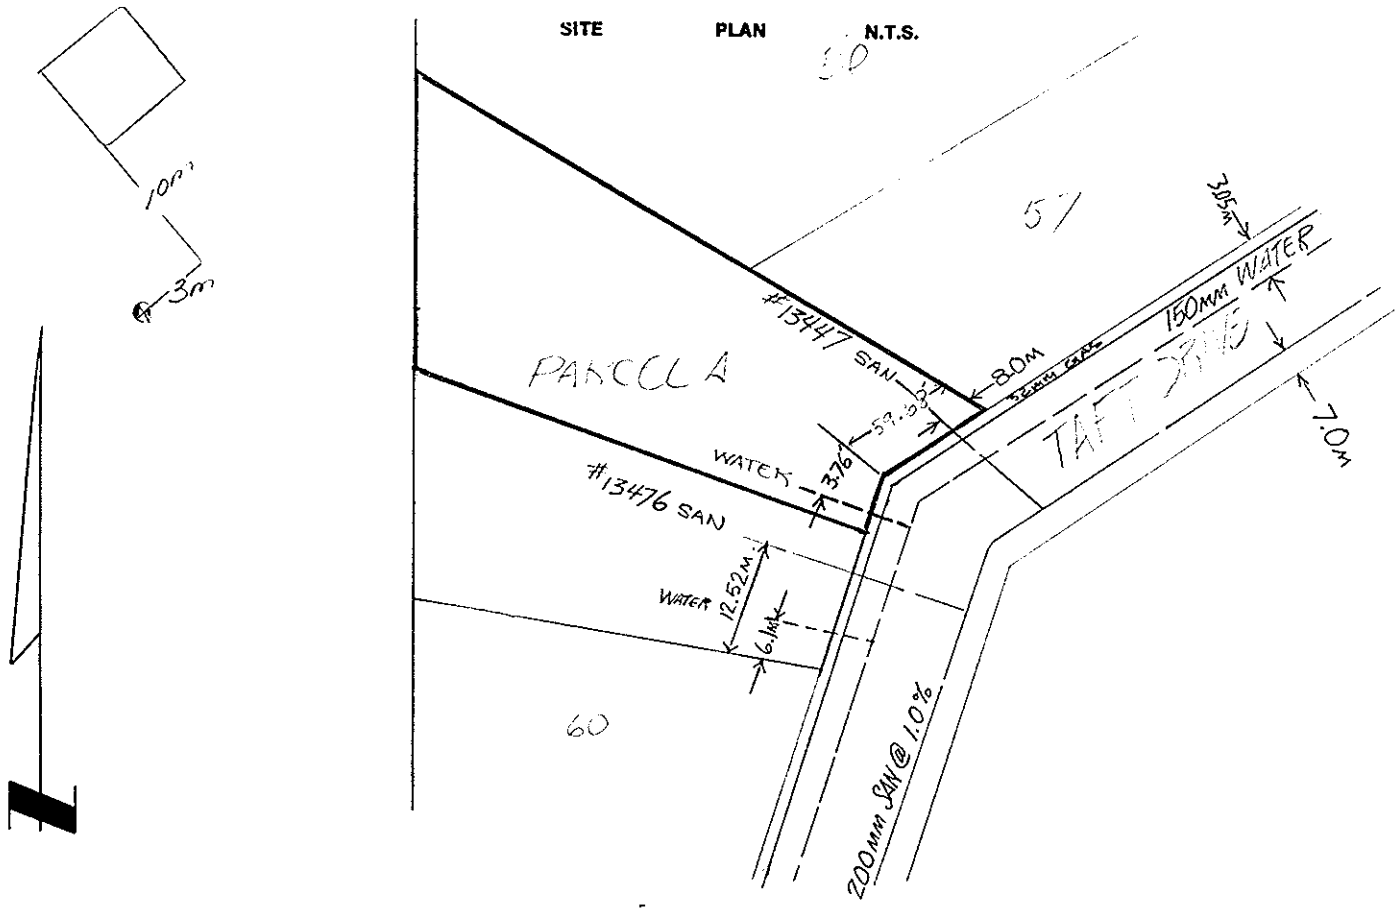
SITE PLAN N.T.S.