City of Prince George
HISTORY SHEET

01088/069

SHEET NUMBER 6758 Roll Number

Legal: LOT'S 37 BLOCK D.L. 4047 PLAN 18801

Address: 7248 GLENVIEW DRIVE

Sanitary Connection: # 12498 SIZE 100mm MATERIAL P.V.C. INV. 30.705 CONNECTED

Water Connection # SIZE 3/4" MATERIAL METER CONNECTED

Storm Connection: # SIZE MATERIAL INV. CONNECTED

Cash Receipt No's: WATER SANITARY STORM

CURB FROM PROPERTY LINE PAVEMENT WIDTH

B.C. HYDRO UNDERGROUND CONNECTION

B.C. TELEPHONE UNDERGROUND CONNECTION

INLAND GAS

Information Sheets:

Comments: MID WATER SERVICE - 20' NORTH OF SOUTH PL

OWNER: SMITH RUSSELL THOMAS & GWENDA GAIL 1-7-76
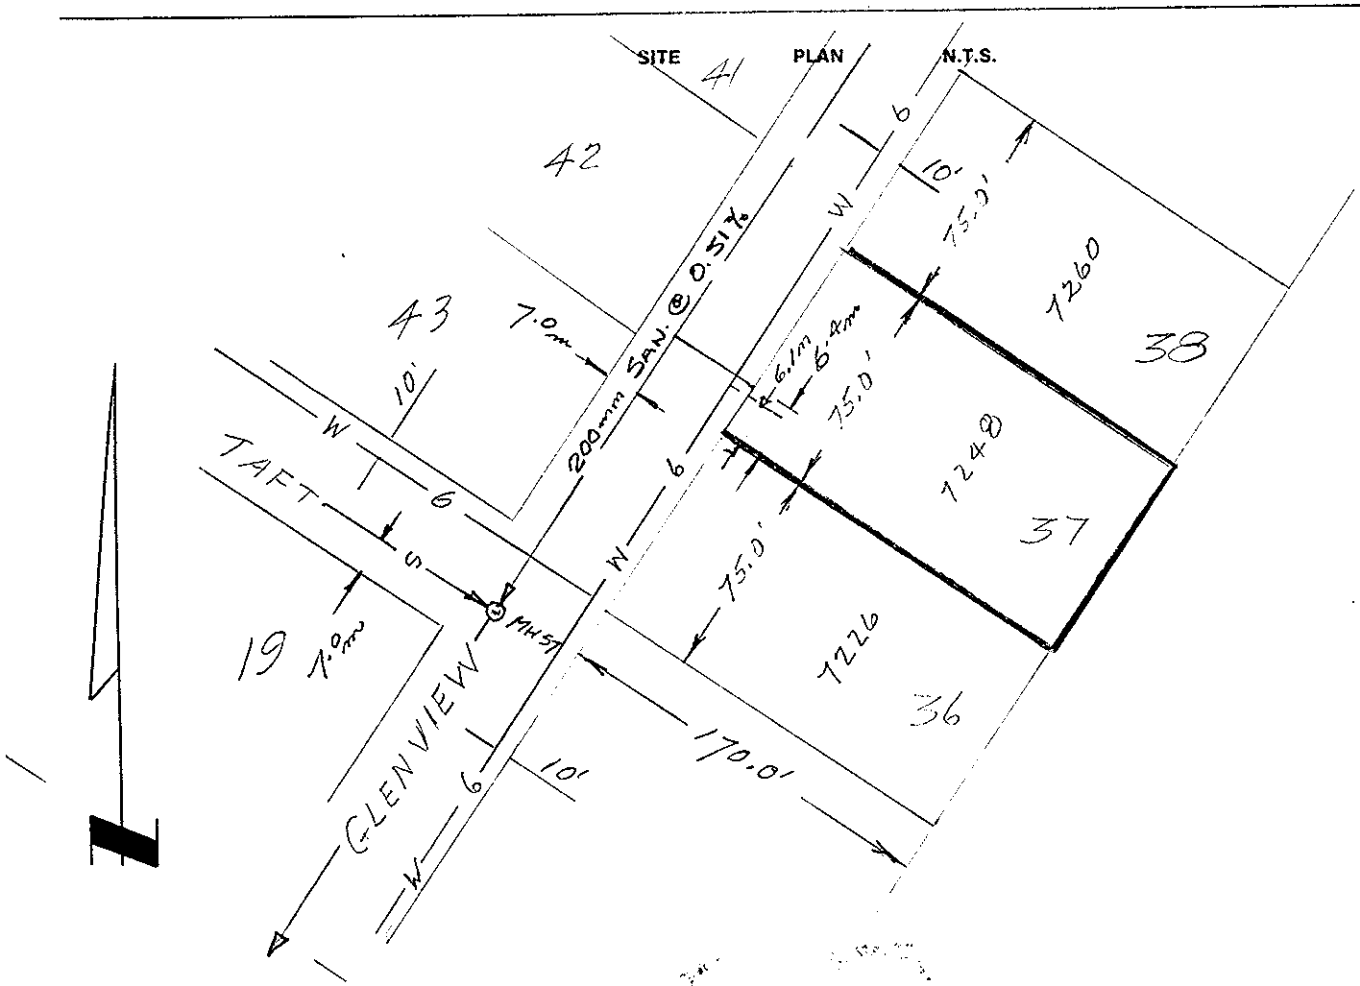
SITE PLAN N.T.S.