City of Prince George
HISTORY SHEET

016908463

SHEET NUMBER 6736 Roll Number

Legal: LOT'S 15 BLOCK D.L. 4047 PLAN 18801

Address: 7254 TAFT DRIVE

Sanitary Connection: # 13507 SIZE 100mm MATERIAL P.V.C. INV. 31.975m CONNECTED

Water Connection # SIZE 20mm MATERIAL Cu METER CONNECTED

Storm Connection: # SIZE MATERIAL INV. CONNECTED

Cash Receipt No's: WATER SANITARY STORM

CURB FROM PROPERTY LINE PAVEMENT WIDTH

B.C. HYDRO UNDERGROUND CONNECTION

B.C. TELEPHONE UNDERGROUND CONNECTION

INLAND GAS

Information Sheets:

Comments: NIL WATER SERVICE - 20' EAST OF WEST PL.
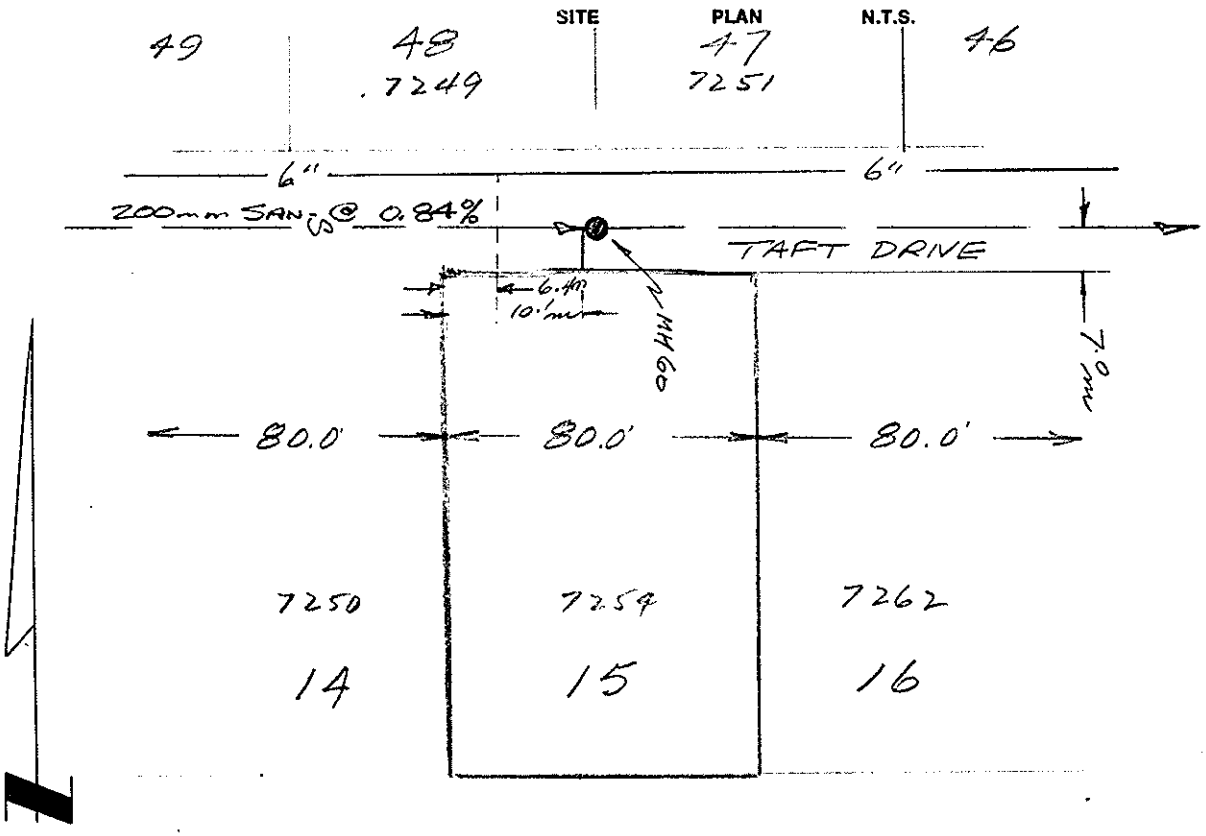
OWNER: HASTEY Leonard Harold Thomas & Carolyn Clara 1-7-75