City of Prince George
HISTORY SHEET

SHEET NUMBER **Roll Number** 010 989 056

Legal: LOT'S 70 BLOCK D.L. 8174/8175 PLAN 17631

Address: 2633 VANIER DRIVE

Sanitary Connection: # 2850 SIZE 100 MM MATERIAL INV. CONNECTED

Water Connection # 2756 SIZE 100 MM MATERIAL C.I. METER CONNECTED

Storm Connection: # 267 SIZE 150 MM MATERIAL INV. CONNECTED

Cash Receipt No's: WATER 262 SANITARY 261 (NON CASH) STORM 263 (NON CASH)

CURB FROM PROPERTY LINE PAVEMENT WIDTH

B.C. HYDRO UNDERGROUND CONNECTION

B.C. TELEPHONE UNDERGROUND CONNECTION

INLAND GAS

Information Sheets:
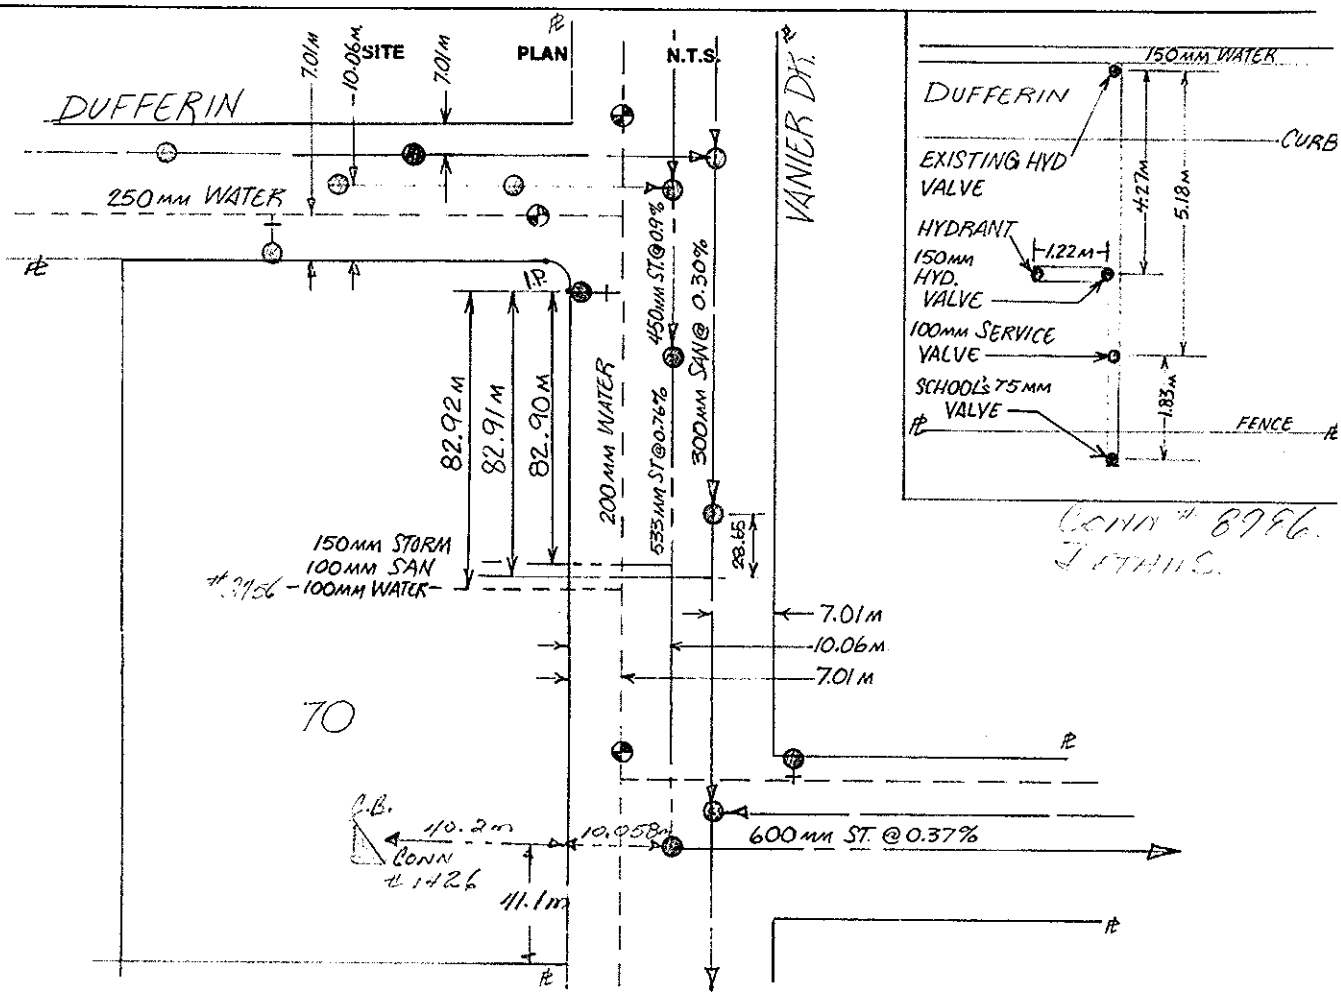
Comments: