City of Prince George
HISTORY SHEET

SHEET NUMBER **Roll Number** 01107643

Legal: LOT'S 24 BLOCK D.L. 1427 PLAN 15314

Address: 199 - 203 McINTYRE CRESCENT

Sanitary Connection: # 5138 SIZE MATERIAL INV. CONNECTED

Water Connection # 5138 SIZE 20 mm MATERIAL COPPER METER CONNECTED

Storm Connection: # SIZE MATERIAL INV. CONNECTED

Cash Receipt No's: WATER SANITARY STORM

CURB FROM PROPERTY LINE PAVEMENT WIDTH

B.C. HYDRO UNDERGROUND UNDERGROUND CONNECTION

B.C. TELEPHONE UNDERGROUND UNDERGROUND CONNECTION

INLAND GAS AS SHOWN

Information Sheets:

Comments:
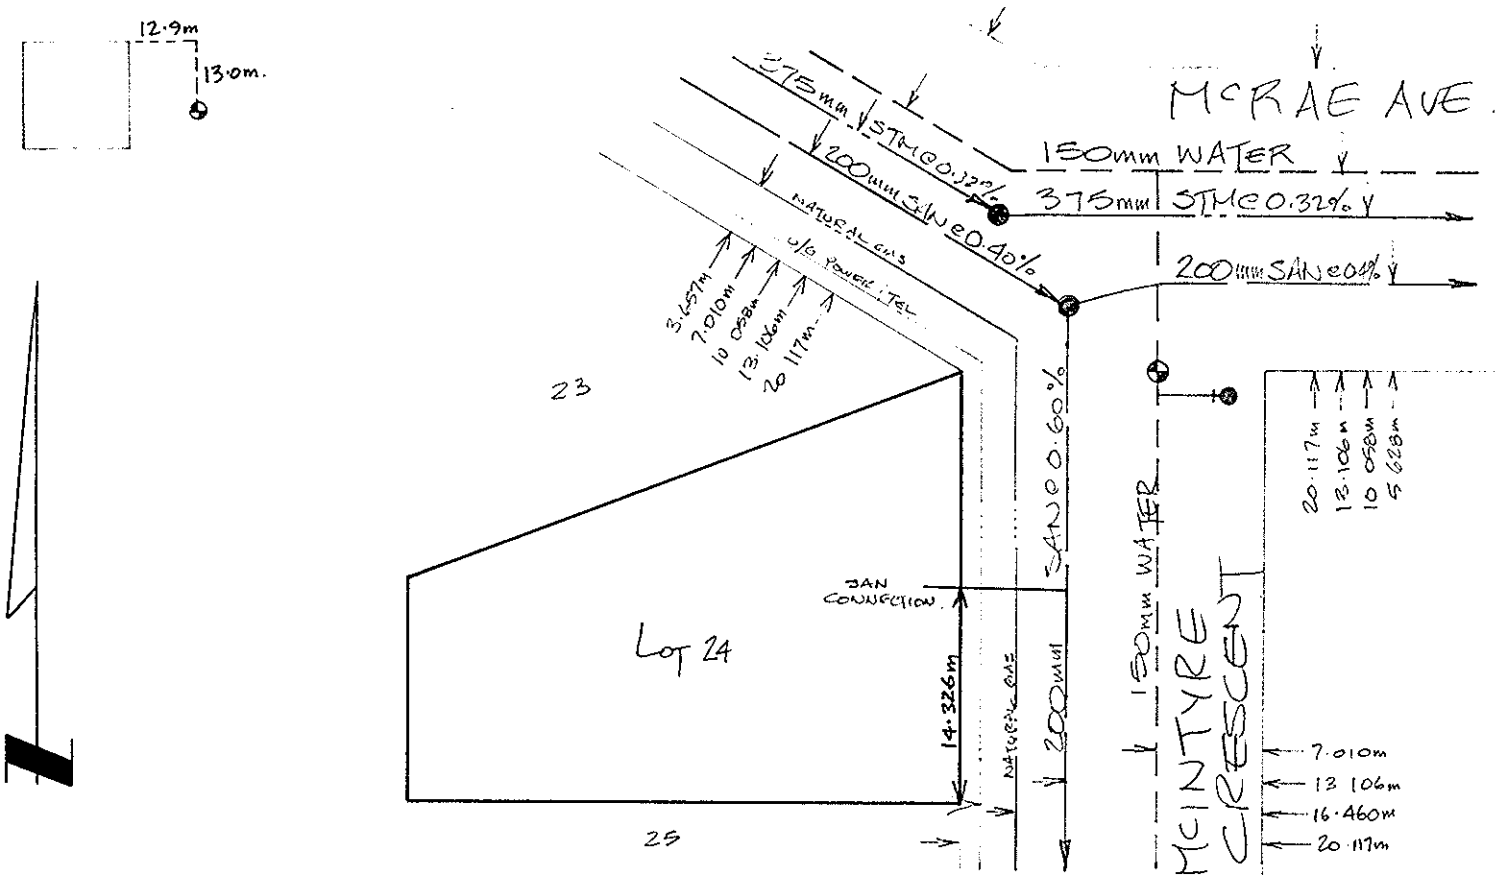
SITE PLAN N.T.S.