City of Prince George
HISTORY SHEET

01113723

SHEET NUMBER 6671 **Roll Number**

Legal: LOT'S 4 BLOCK D.L. 4047 PLAN 18389

Address: 3984 BALSAM DRIVE

Sanitary Connection: # 12477 SIZE 4" MATERIAL INV. 744.103 CONNECTED

Water Connection # SIZE 3/4" MATERIAL Copper METER CONNECTED

Storm Connection: # SIZE MATERIAL INV. CONNECTED

Cash Receipt No's: WATER SANITARY 2373 STORM

CURB FROM PROPERTY LINE PAVEMENT WIDTH

B.C. HYDRO UNDERGROUND CONNECTION

B.C. TELEPHONE UNDERGROUND CONNECTION

INLAND GAS

Information Sheets:

Comments:

THE INFORMATION CONTAINED HEREIN IS FOR INTERNAL USE ONLY. NOT TO BE RELIED UPON UNLESS CONFIRMED BY SITE INSPECTION AND/OR INVESTIGATION.

OWNER: NORKUS Frank & Jean Shirley 1-7-75
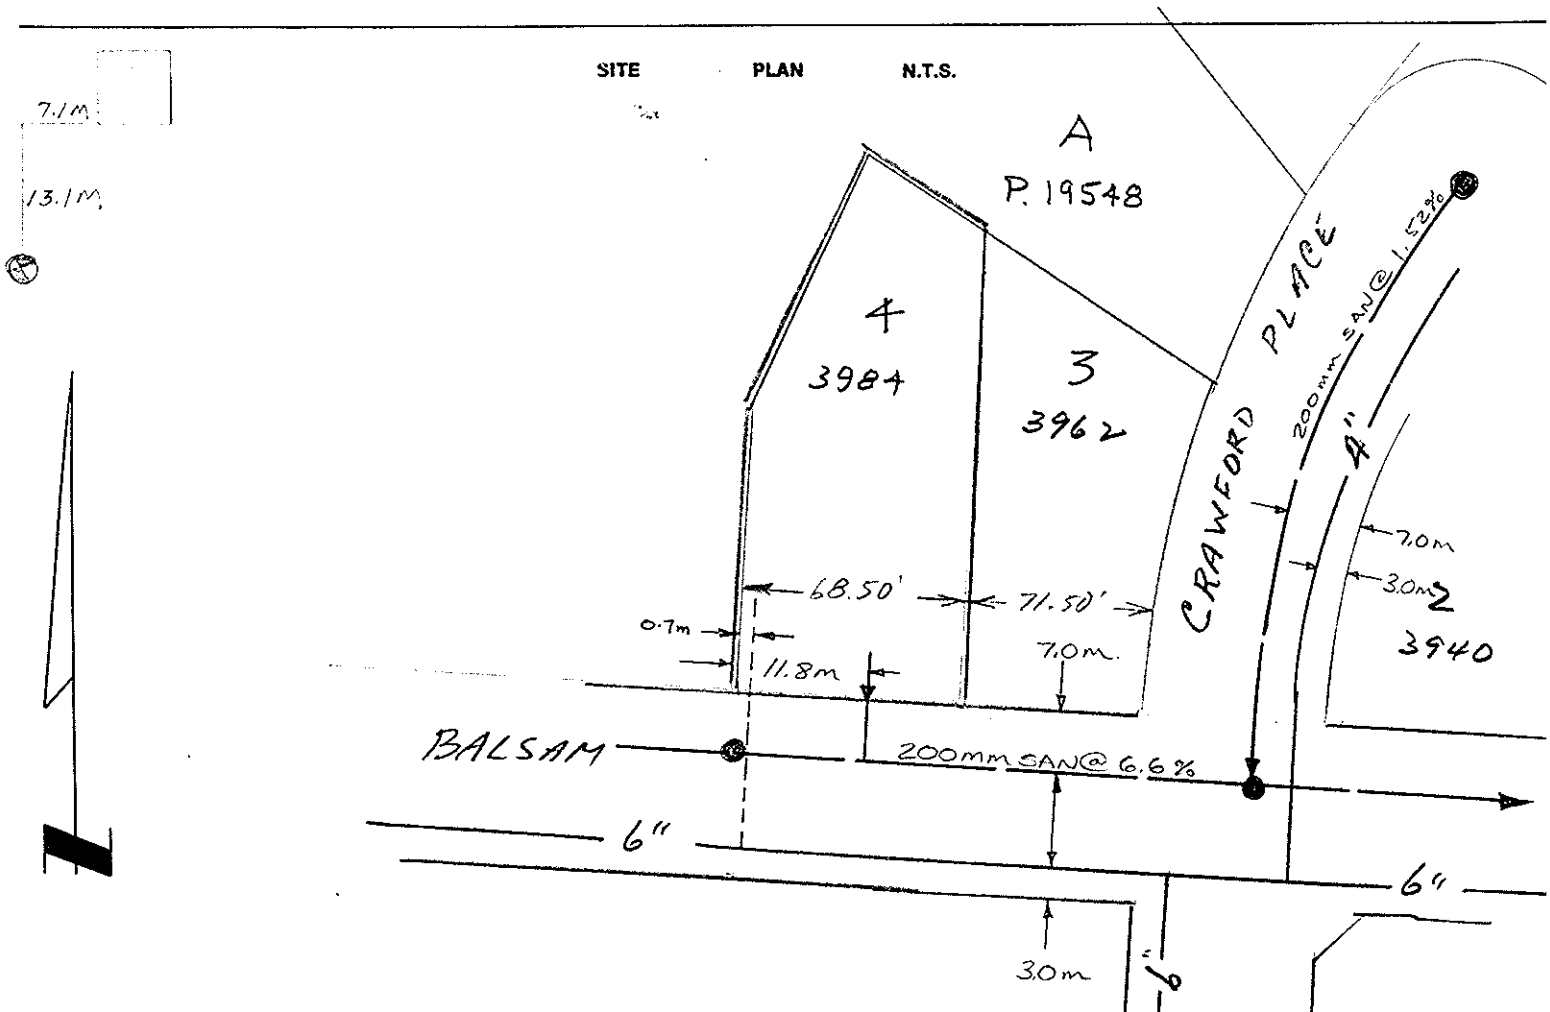
SITE PLAN N.T.S.