City of Prince George
HISTORY SHEET

SHEET NUMBER **Roll Number** 011-179-830

Legal: LOT'S 1 BLOCK D.L. 8178 PLAN 18143

Address: 177 IVY STREET

Sanitary Connection: # 6353 SIZE 100 mm MATERIAL INV. CONNECTED

Water Connection # 6353 SIZE 20 mm MATERIAL METER CONNECTED

Storm Connection: # SIZE MATERIAL INV. CONNECTED

Cash Receipt No's: WATER SANITARY STORM

CURB FROM PROPERTY LINE PAVEMENT WIDTH

B.C. HYDRO UNDERGROUND CONNECTION

B.C. TELEPHONE UNDERGROUND CONNECTION

INLAND GAS

Information Sheets:

Comments:
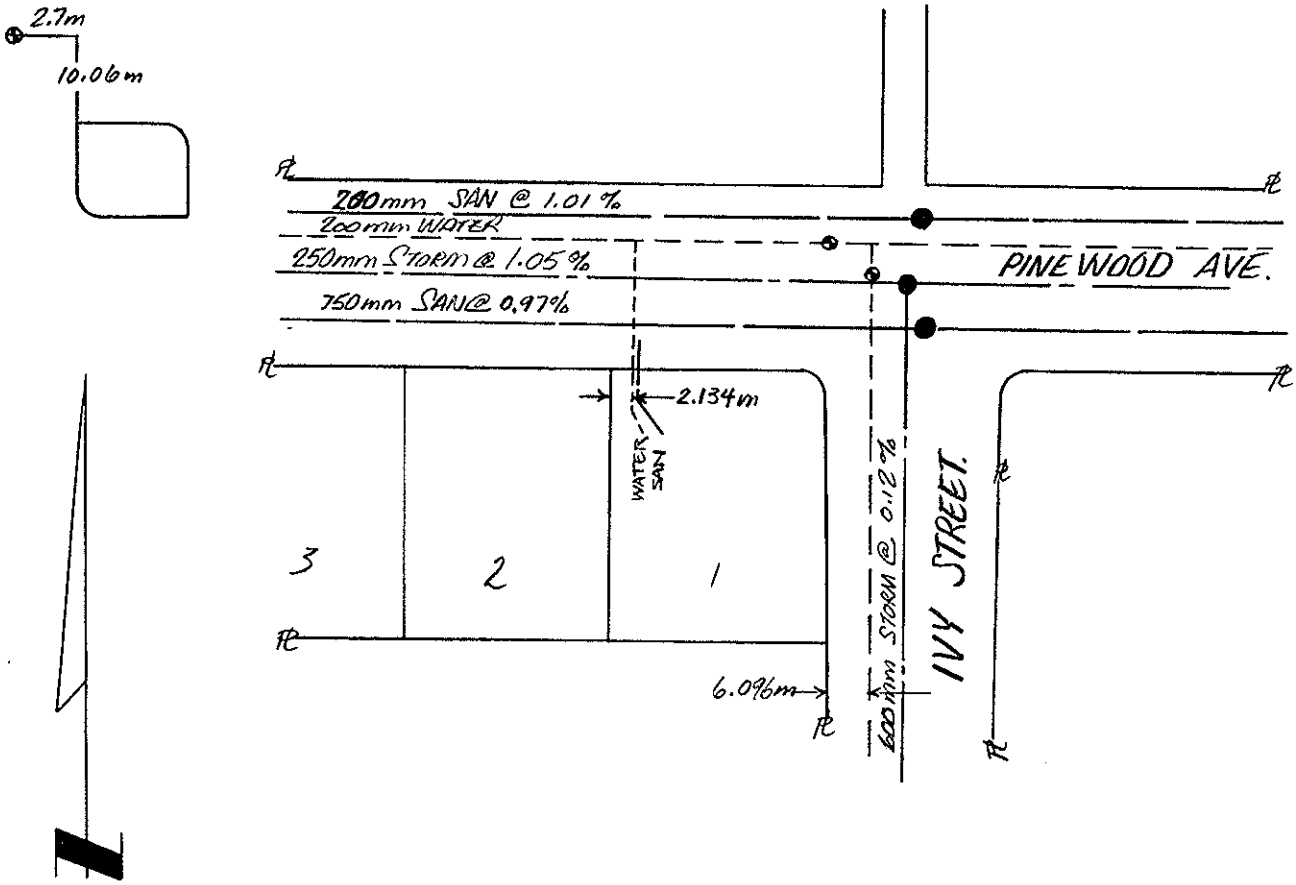
THE INFORMATION CONTAINED HEREIN IS FOR INTERNAL USE ONLY.
NOT TO BE RELIED UPON UNLESS CONFIRMED BY SITE INSPECTION AND/OR INVESTIGATION