City of Prince George
HISTORY SHEET

SHEET NUMBER № 2893 **Roll Number** 011181079

Legal: LOT'S K (Rem) BLOCK D.L. 7634 PLAN 18047

Address: 4307 CRAIG DR.

Sanitary Connection: # SIZE 100mm MATERIAL P.V.C. INV. CONNECTED

Water Connection # SIZE 20mm MATERIAL CU. METER CONNECTED

Storm Connection: # SIZE MATERIAL INV. CONNECTED

Cash Receipt No's: WATER SANITARY STORM

CURB FROM PROPERTY LINE PAVEMENT WIDTH 10.00 m

B.C. HYDRO O/H UNDERGROUND CONNECTION

B.C. TELEPHONE O/H UNDERGROUND CONNECTION

INLAND GAS AS SHOWN

Information Sheets:
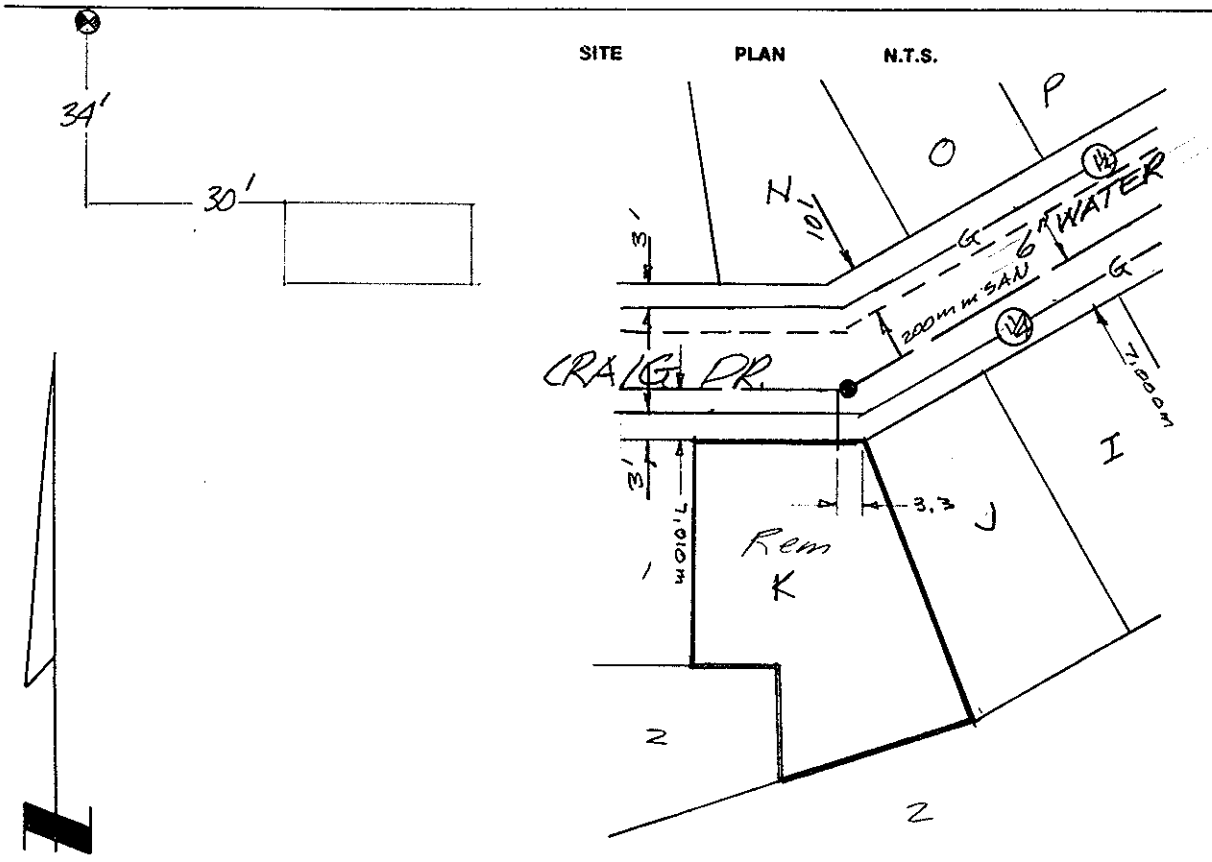
Comments: