City of Prince George
HISTORY SHEET

SHEET NUMBER **Roll Number** 011203731

Legal: LOT'S REM 38 BLOCK D.L. 754 PLAN 10486

Address: 2650 PARENT RD.

Sanitary Connection: # SIZE 100mm MATERIAL P.V.C. INV. CONNECTED

Water Connection # SIZE 20mm MATERIAL CU. METER CONNECTED

Storm Connection: # SIZE 100mm MATERIAL P.V.C INV. CONNECTED

Cash Receipt No's: WATER 11317 SANITARY 11317 STORM 11317

CURB FROM PROPERTY LINE No CURB PAVEMENT WIDTH 10.000m

B.C. HYDRO O/H UNDERGROUND CONNECTION

B.C. TELEPHONE O/H UNDERGROUND CONNECTION

INLAND GAS AS SHOWN

Information Sheets:

Comments:
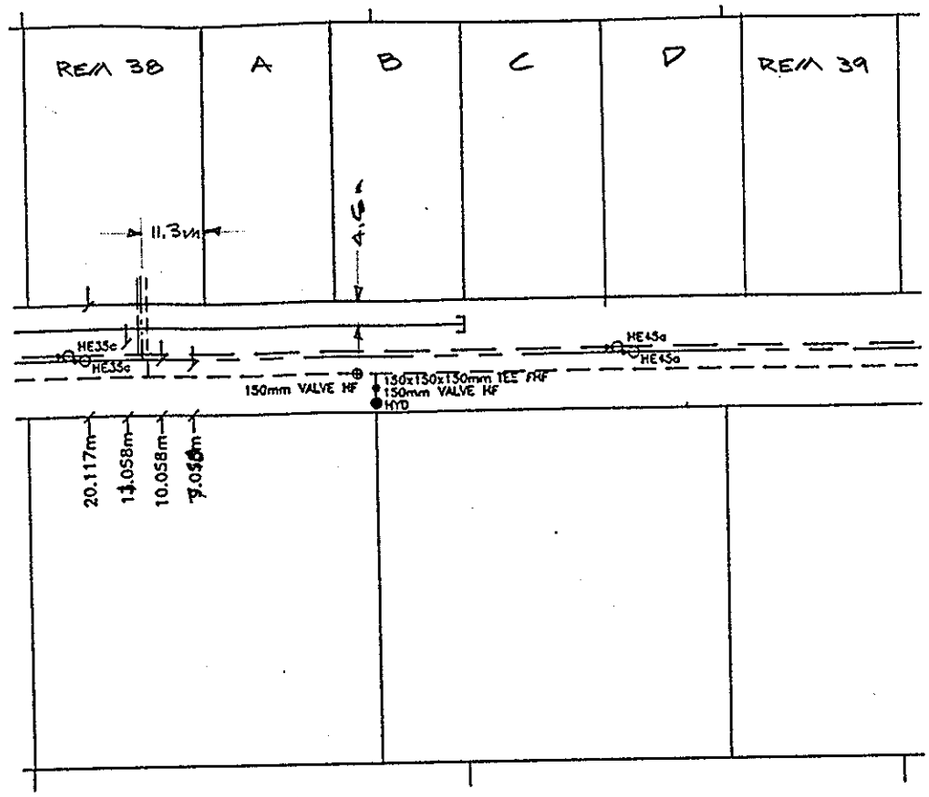
THE INFORMATION CONTAINED HEREIN IS FOR INTERNAL USE ONLY.
NOT TO BE RELIED UPON UNLESS CONFIRMED BY SITE INSPECTION AND/OR INVESTIGATION