City of Prince George
HISTORY SHEET

SHEET NUMBER **Roll Number** 011230 410

Legal: LOT'S 6 BLOCK D.L. 753 PLAN 15944

Address: 2767 STARLANE PLACE

Sanitary Connection: # SIZE 100 ϕ MATERIAL PVC INV. CONNECTED

Water Connection # SIZE 19 ϕ MATERIAL Copper METER NO CONNECTED

Storm Connection: # SIZE N/A MATERIAL INV. CONNECTED

Cash Receipt No's: WATER SANITARY STORM

CURB FROM PROPERTY LINE N/A PAVEMENT WIDTH

B.C. HYDRO O/H UNDERGROUND CONNECTION NO

B.C. TELEPHONE O/H UNDERGROUND CONNECTION NO

INLAND GAS 1.5 m FROM PL.

Information Sheets:

Comments: OVERHEAD HYDRO, TELEPHONE & CABLE
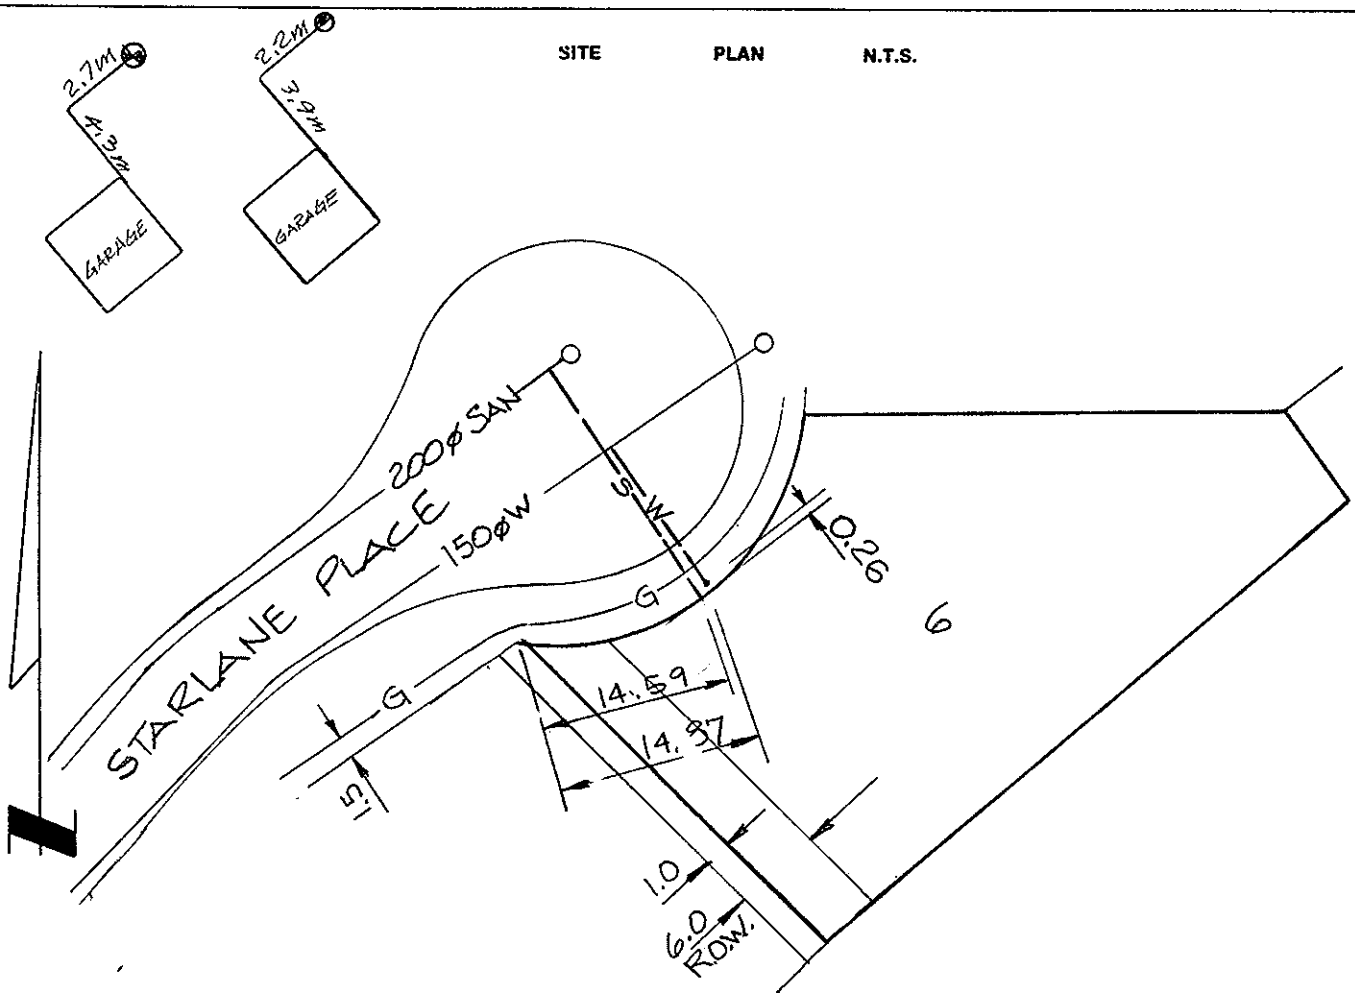
SITE PLAN N.T.S.