City of Prince George
HISTORY SHEET

SHEET NUMBER

Roll Number 01230461

Legal: LOT'S 11 BLOCK D.L. 753 PLAN 15944

Address: 2788 STARLANE PLACE

Sanitary Connection: # SIZE 100 ø MATERIAL PVC INV. 641.06 CONNECTED

Water Connection # SIZE 19 ø MATERIAL COPPER METER NO CONNECTED

Storm Connection: # SIZE N/A MATERIAL INV. CONNECTED

Cash Receipt No's: WATER SANITARY STORM

CURB FROM PROPERTY LINE N/A PAVEMENT WIDTH

B.C. HYDRO UNDERGROUND CONNECTION NO

B.C. TELEPHONE UNDERGROUND CONNECTION NO

INLAND GAS

THE INFORMATION CONTAINED HEREIN IS FOR INTERNAL USE ONLY. NOT TO BE RELIED UPON UNLESS CONFIRMED BY SITE INSPECTION AND/OR INVESTIGATION.

Information Sheets:

Comments: OVERHEAD HYDRO, TELEPHONE & CABLE
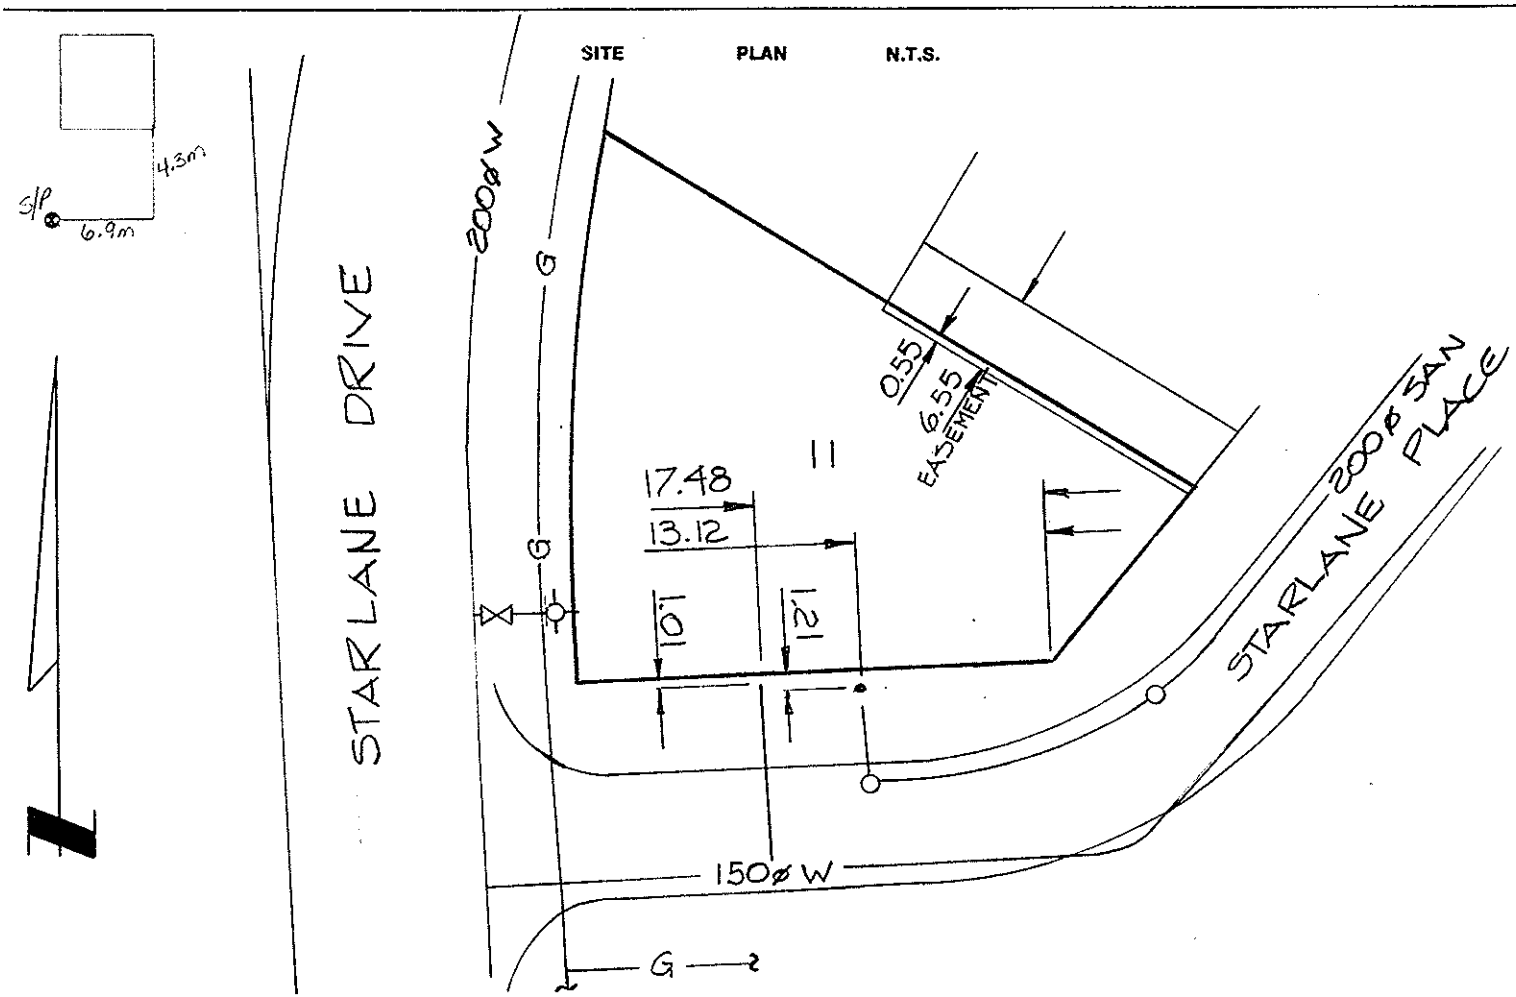
SITE PLAN N.T.S.