# City of Prince George
## HISTORY SHEET

D S

SHEET NUMBER 11763 **Roll Number** 011232706

**Legal:** LOT'S 1 BLOCK D.L. 3050 PLAN 18026

**Address:** 1569 N. NECHAKO RD.

**Sanitary Connection:** # SIZE MATERIAL INV. CONNECTED

**Water Connection** # SIZE MATERIAL METER CONNECTED

**Storm Connection:** # SIZE MATERIAL INV. CONNECTED

**Cash Receipt No's:** WATER SANITARY STORM

CURB FROM PROPERTY LINE PAVEMENT WIDTH

B.C. HYDRO UNDERGROUND CONNECTION

B.C. TELEPHONE UNDERGROUND CONNECTION

INLAND GAS

**Information Sheets:**

**Comments:**
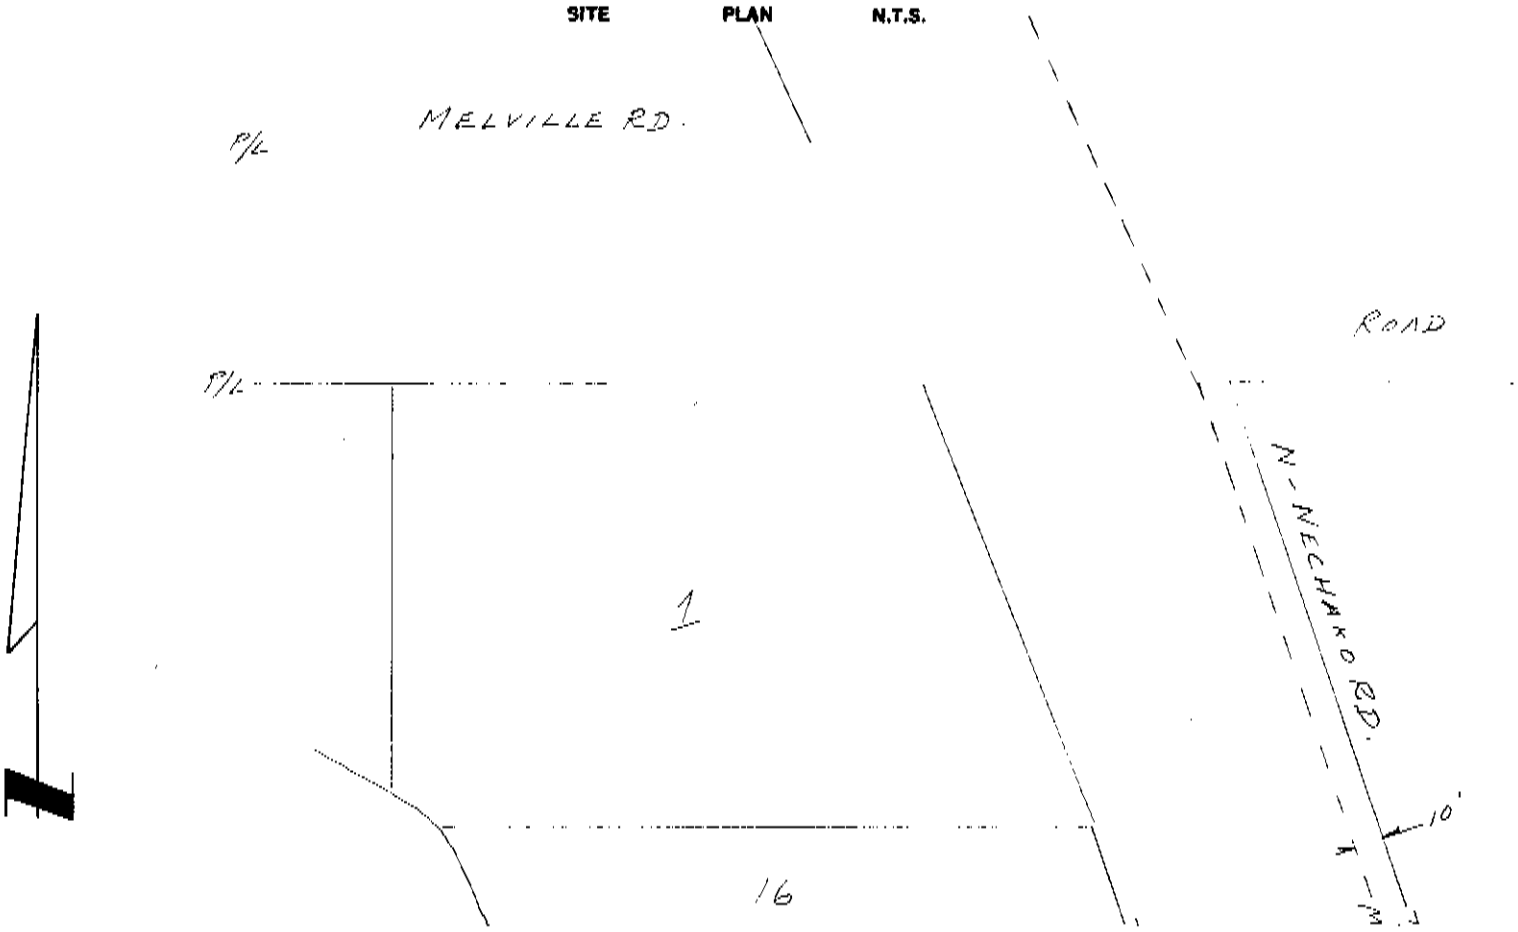
**SITE PLAN N.T.S.**