City of Prince George
HISTORY SHEET

B11257385

SHEET NUMBER **6634** **Roll Number**

Legal: LOT'S Q BLOCK D.L. 4047 PLAN 17915

Address: 5995 BIRCHWOOD DDRIVE

Sanitary Connection: # 11895 SIZE 4" MATERIAL INV. 729.532 CONNECTED

Water Connection # SIZE 3/4" MATERIAL copper METER CONNECTED

Storm Connection: # SIZE MATERIAL INV. CONNECTED

Cash Receipt No's: WATER SANITARY 2589 STORM

CURB FROM PROPERTY LINE PAVEMENT WIDTH

B.C. HYDRO OH UNDERGROUND CONNECTION

B.C. TELEPHONE O.H. UNDERGROUND CONNECTION

INLAND GAS AS SHOWN.

Information Sheets:

Comments:

OWNER: GOODVIN Eileen 1-7-75
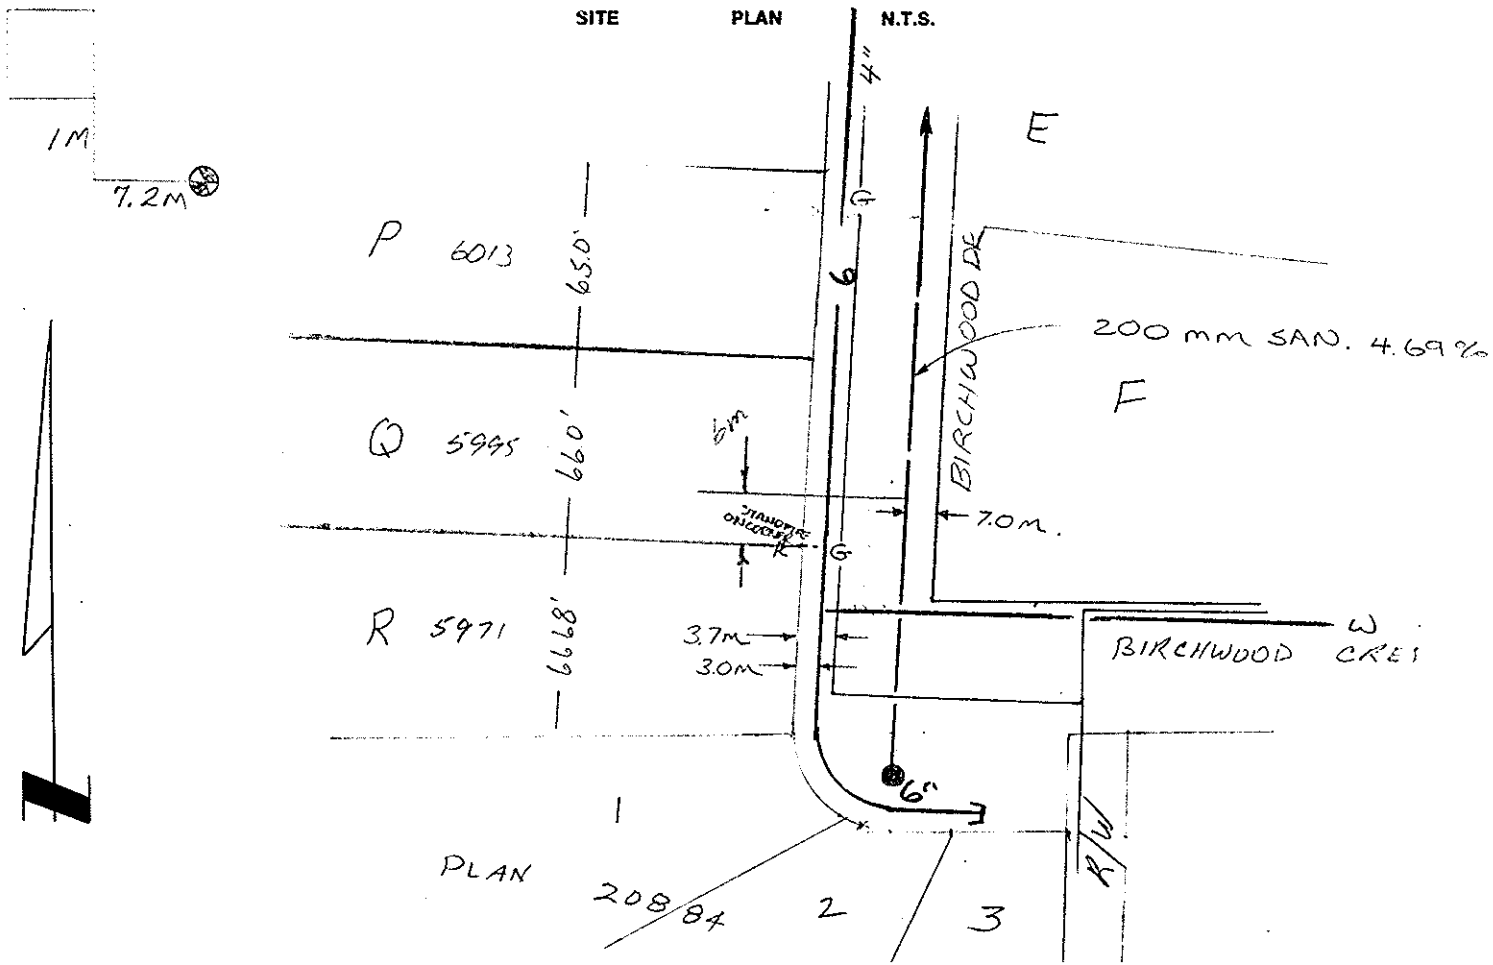
SITE PLAN N.T.S.