# City of Prince George
## HISTORY SHEET

SHEET NUMBER **Roll Number** 394498

**Legal:** LOT'S 58 BLOCK D.L. 1421 PLAN 16863.


**Sanitary Connection:** # 6127 SIZE 100mm MATERIAL AC INV. 605.365 CONNECTED

**Water Connection** # 6127 SIZE 20mm MATERIAL Cu METER CONNECTED

**Storm Connection:** # SIZE MATERIAL INV. CONNECTED

**Cash Receipt No's:** WATER SANITARY STORM

CURB FROM PROPERTY LINE 4.877m PAVEMENT WIDTH 10.36m

B.C. HYDRO UNDERGROUND CONNECTION

B.C. TELEPHONE UNDERGROUND CONNECTION

INLAND GAS

**Information Sheets:**

**Comments:**
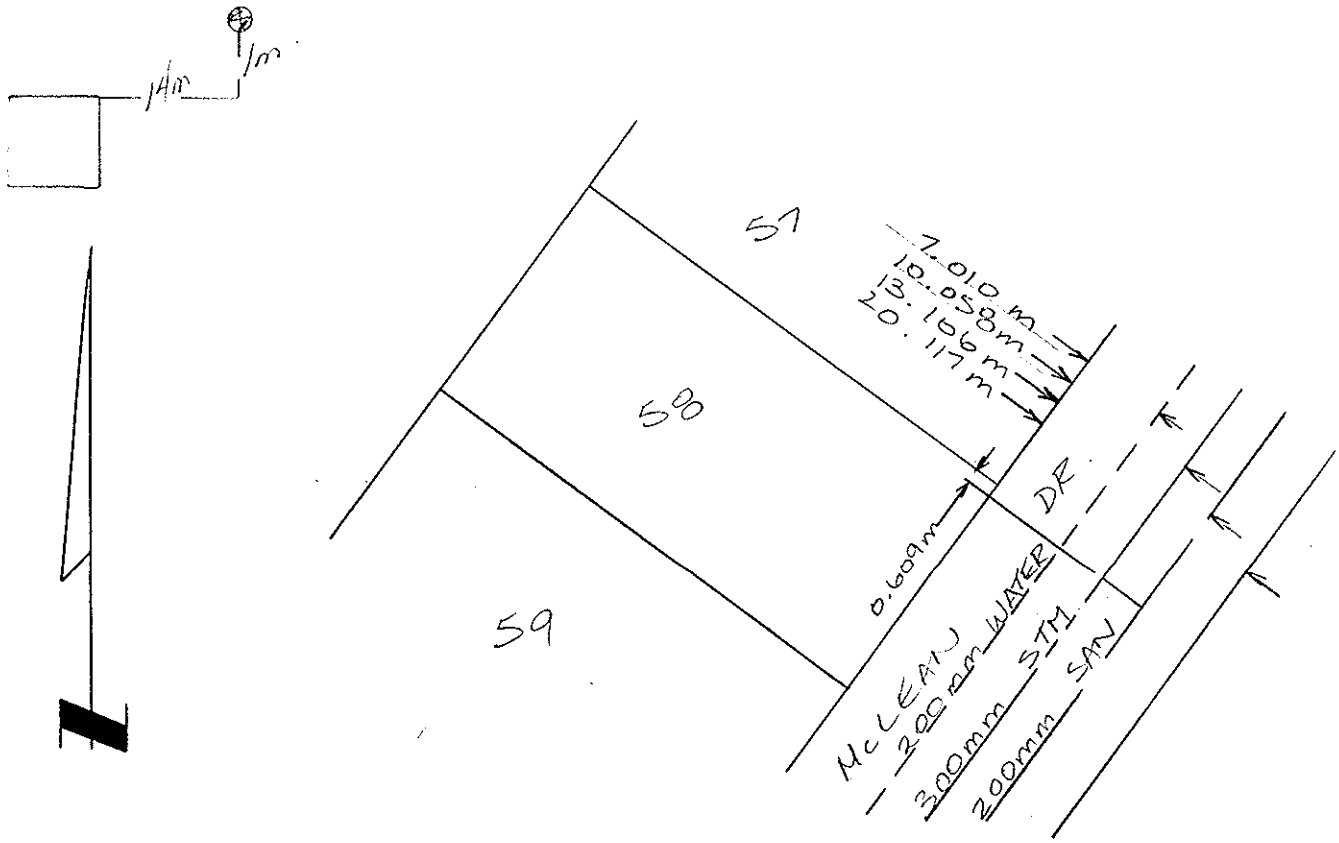
SITE PLAN N.T.S.