City of Prince George
HISTORY SHEET

SHEET NUMBER **Roll Number** 011470 852

Legal: LOT'S 43 BLOCK HIGHLAND D.L. 1427 PLAN 16298

Address: 125 KING DRIVE

Sanitary Connection: # 5846 SIZE 100mm MATERIAL AC INV. 604.66 CONNECTED

Water Connection # 5846 SIZE 20mm MATERIAL CU METER CONNECTED

Storm Connection: # SIZE MATERIAL INV. CONNECTED

Cash Receipt No's: WATER SANITARY STORM

CURB FROM PROPERTY LINE 4.9m PAVEMENT WIDTH 10.4m

B.C. HYDRO ENG DWG 30'0"4 UNDERGROUND CONNECTION

B.C. TELEPHONE UT 33 UNDERGROUND CONNECTION

INLAND GAS 30mm LINE @ 3m from PROPERTY LINE

Information Sheets:

Comments:
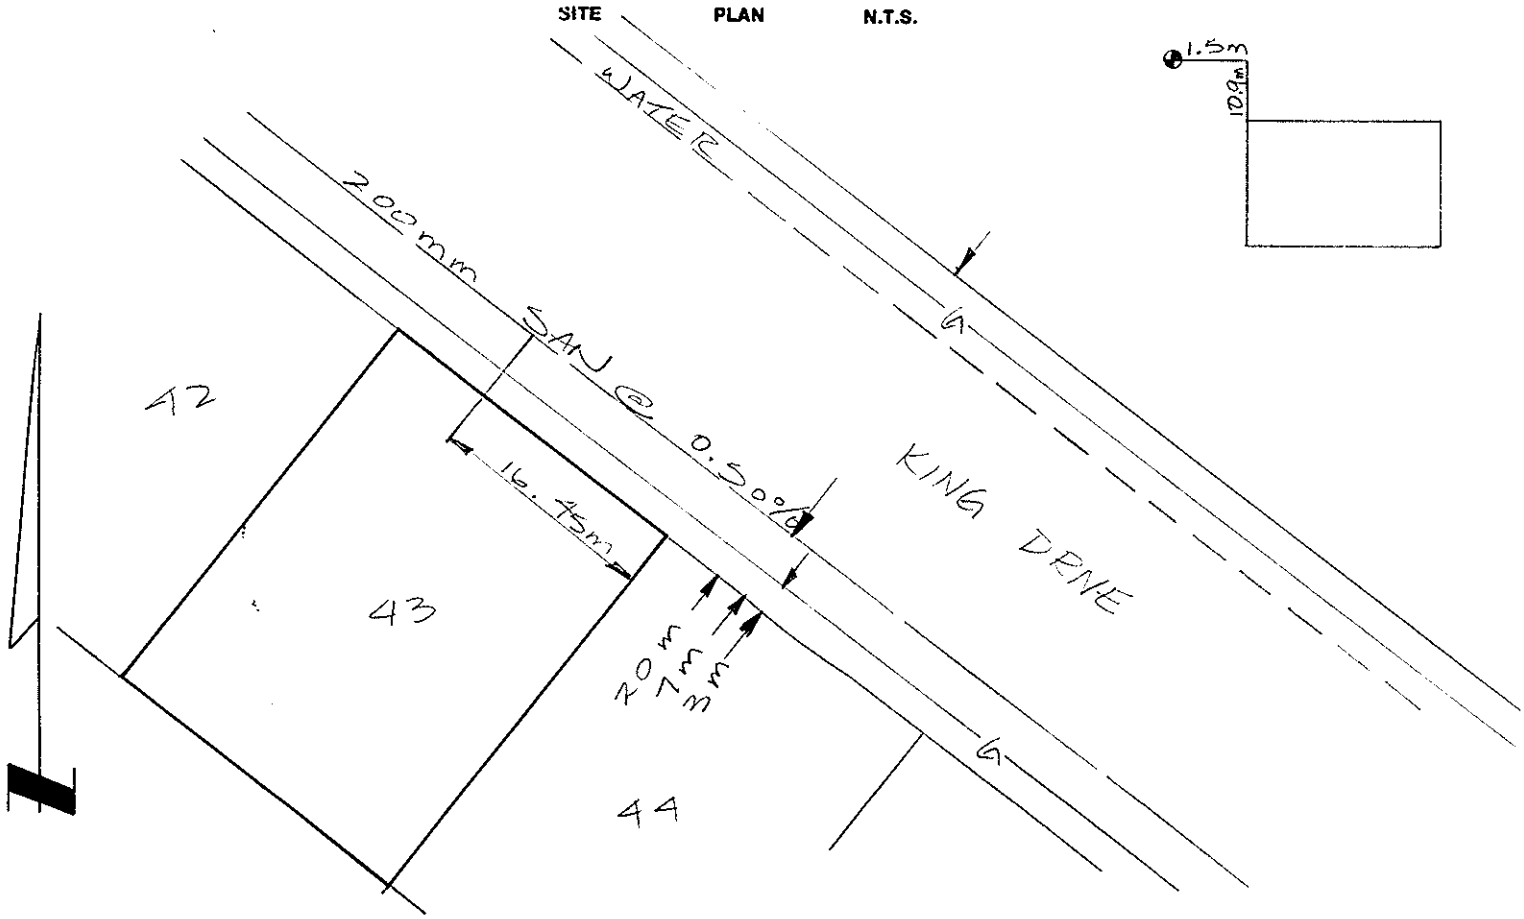
SITE PLAN N.T.S.