City of Prince George
HISTORY SHEET

011572922

SHEET NUMBER 6186 **Roll Number**

Legal: LOT'S 36 BLOCK D.L. 4047 PLAN 17047

Address: 6918 DAGG ROAD (Northeast Corner EDEN DRIVE)

Sanitary Connection: # 13464 SIZE 100mm MATERIAL P.V.C. INV. 34.800m CONNECTED

Water Connection # SIZE 3/4 MATERIAL METER CONNECTED

Storm Connection: # SIZE MATERIAL INV. CONNECTED

Cash Receipt No's: WATER SANITARY STORM

CURB FROM PROPERTY LINE PAVEMENT WIDTH

B.C. HYDRO UNDERGROUND CONNECTION

B.C. TELEPHONE UNDERGROUND CONNECTION

INLAND GAS

Information Sheets:

Comments: MC Water Service - 20mm 1973

OWNER: BLANGY, Charles 1-7-75

The information contained herein is for internal use only. Not to be relied upon unless confirmed by site inspection and/or investigation.
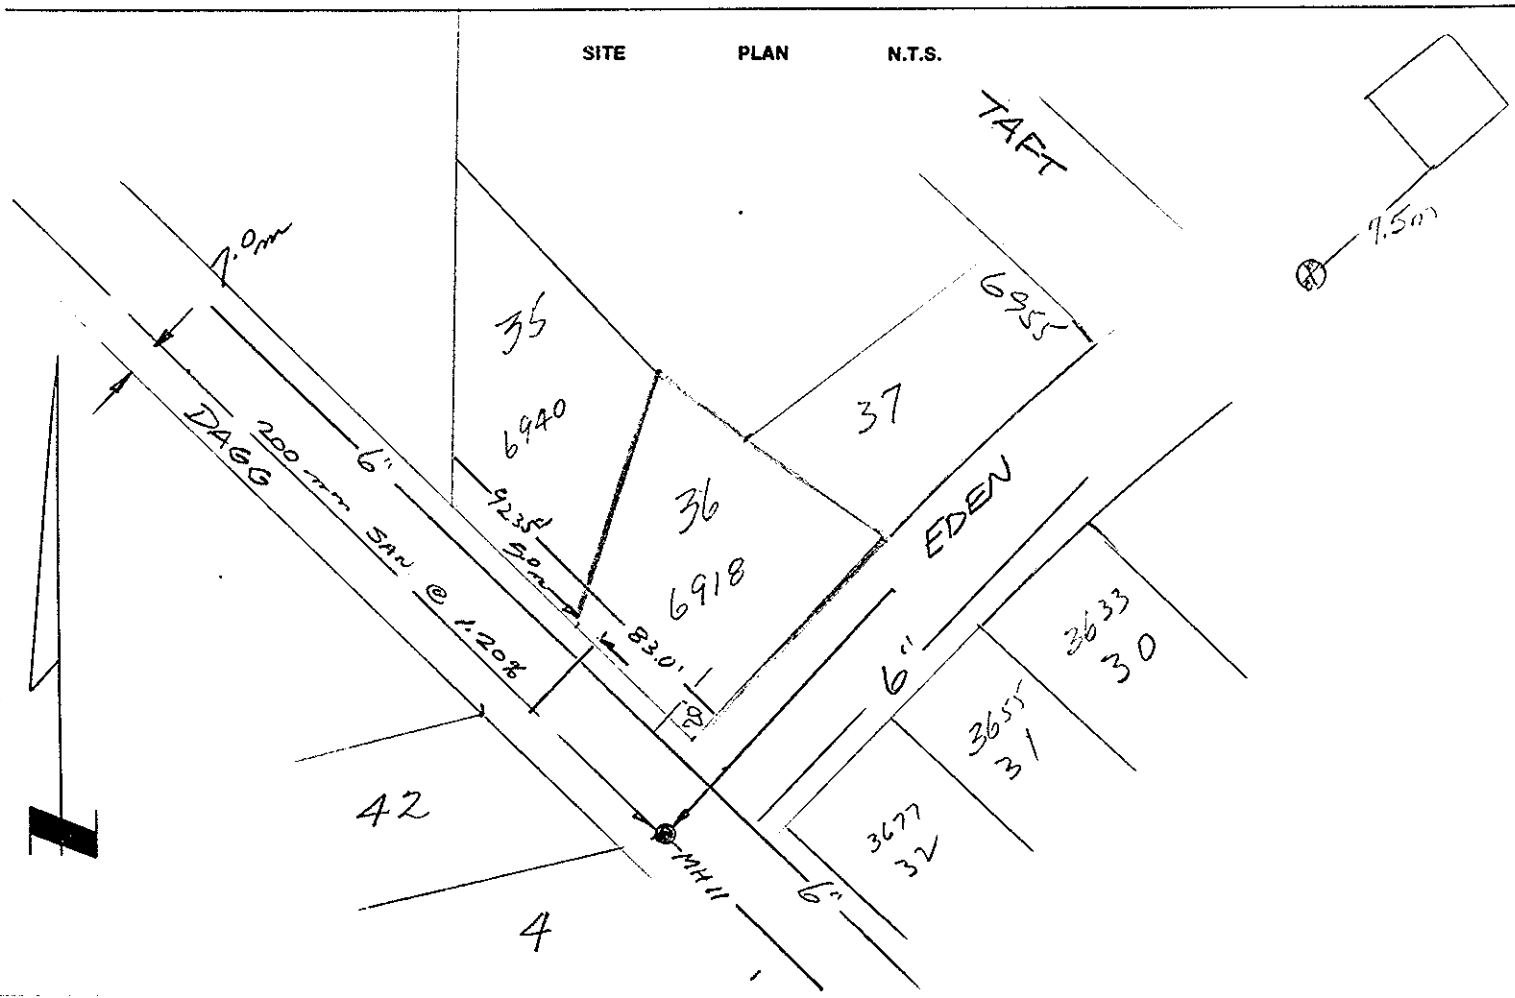
SITE PLAN N.T.S.