City of Prince George
HISTORY SHEET

SHEET NUMBER № 1678 **Roll Number** 011645402

Legal: LOT'S 33 BLOCK D.L. 1427 PLAN 16991

Address: 191 GORDON CRES.

Sanitary Connection: # 6088 SIZE 100 mm MATERIAL A.C. INV. 604.755 CONNECTED

Water Connection # 6088 SIZE 20 mm MATERIAL CU. METER CONNECTED

Storm Connection: # SIZE MATERIAL INV. CONNECTED

Cash Receipt No's: WATER SANITARY STORM

CURB FROM PROPERTY LINE 4.877 m PAVEMENT WIDTH 10.363 m

B.C. HYDRO U/G UNDERGROUND CONNECTION

B.C. TELEPHONE U/G UNDERGROUND CONNECTION

INLAND GAS 3.048 m FROM PL.

Information Sheets:

Comments:
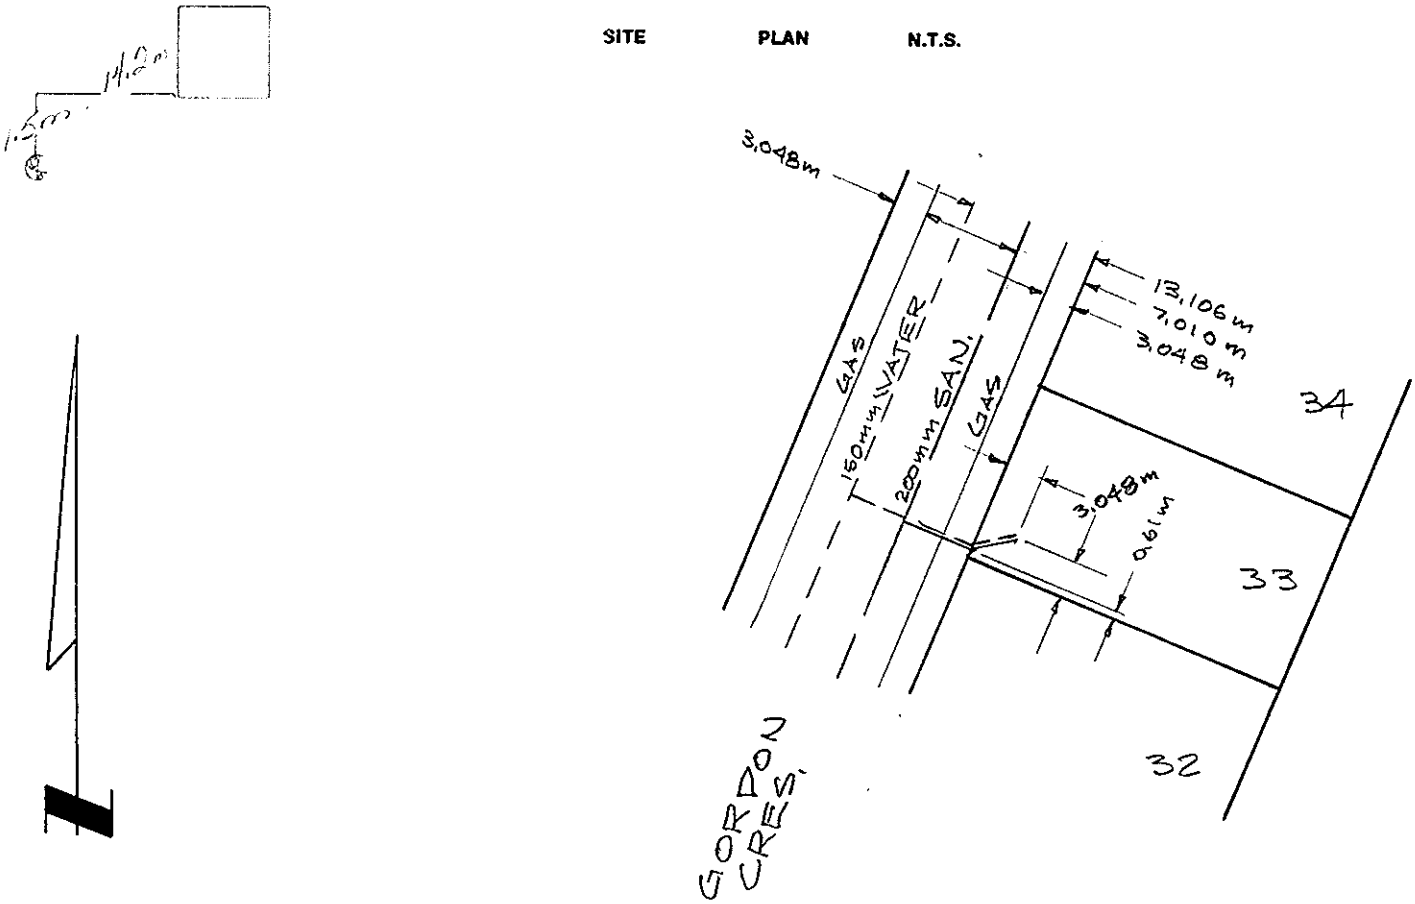
SITE PLAN N.T.S.