City of Prince George
HISTORY SHEET

SHEET NUMBER **PID #** 011735724

Legal: LOT'S 29 BLOCK D.L. 925 PLAN 16674

Address: 542 RUNNALS AVE.

Sanitary Connection: # 5601 SIZE 100 mm MATERIAL A.C INV. 585.620 CONNECTED

Water Connection: # 5601 SIZE 20 mm MATERIAL CU. METER CONNECTED

Storm Connection: # SIZE mm MATERIAL INV. CONNECTED

Cash Receipt No's: WATER SANITARY STORM

CURB FROM PROPERTY LINE 4.877 m PAVEMENT WIDTH 10.363 m

B.C. HYDRO U/G UNDERGROUND CONNECTION

B.C. TELEPHONE U/G UNDERGROUND CONNECTION

INLAND GAS 3.048 m FROM PL

Information Sheets:

Comments: WITH THAW WIRE.
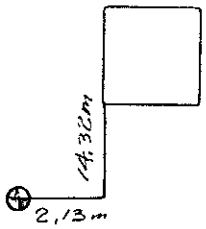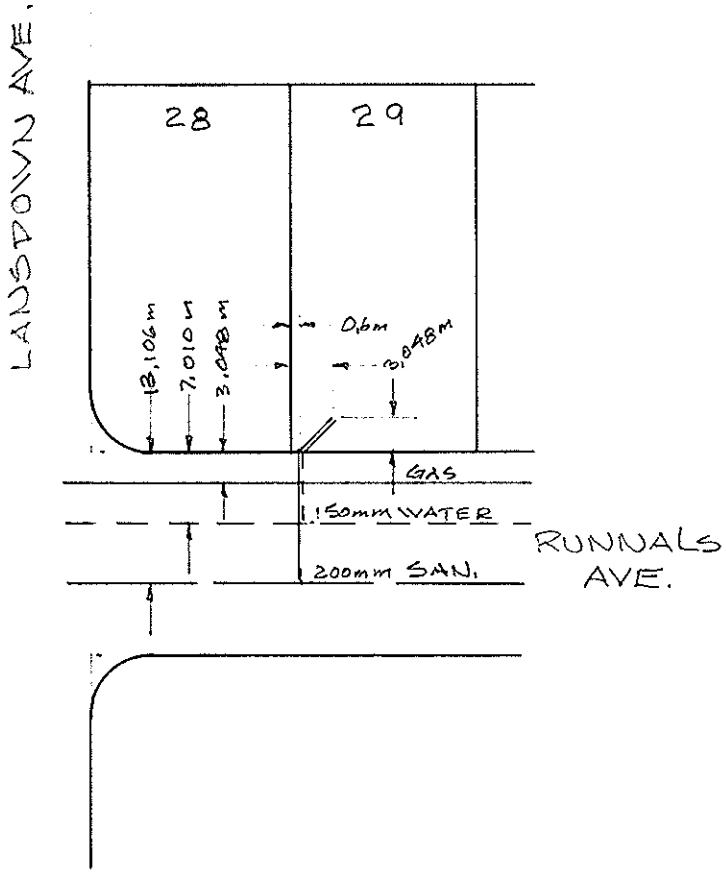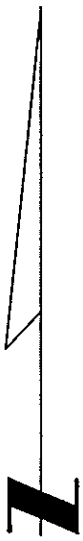
THE INFORMATION CONTAINED HEREIN IS FOR INTERNAL USE ONLY.
NOT TO BE RELIED UPON UNLESS CONFIRMED BY SITE INSPECTION AND/OR INVESTIGATION