City of Prince George
HISTORY SHEET

SHEET NUMBER 10493 **Roll Number** C117 45 681

Legal: LOT'S 1 BLOCK D.L. 2433 PLAN 16589

Address: 4050 GLENDALE DR.

Sanitary Connection: # 16565 SIZE 100mm MATERIAL PVC INV. CONNECTED

Water Connection # SIZE 3/4" MATERIAL Copper METER CONNECTED

Storm Connection: # SIZE MATERIAL INV. CONNECTED

Cash Receipt No's: WATER SANITARY STORM

CURB FROM PROPERTY LINE PAVEMENT WIDTH

B.C. HYDRO UNDERGROUND CONNECTION

B.C. TELEPHONE UNDERGROUND CONNECTION

INLAND GAS

Information Sheets:

Comments: N/C WATER SERVICES ON EAST CORNER

THE INFORMATION CONTAINED HEREIN IS FOR INTERNAL USE ONLY [illegible] UNLESS CONFIRMED BY SITE INSPECTION AND/OR INVESTIGATION.
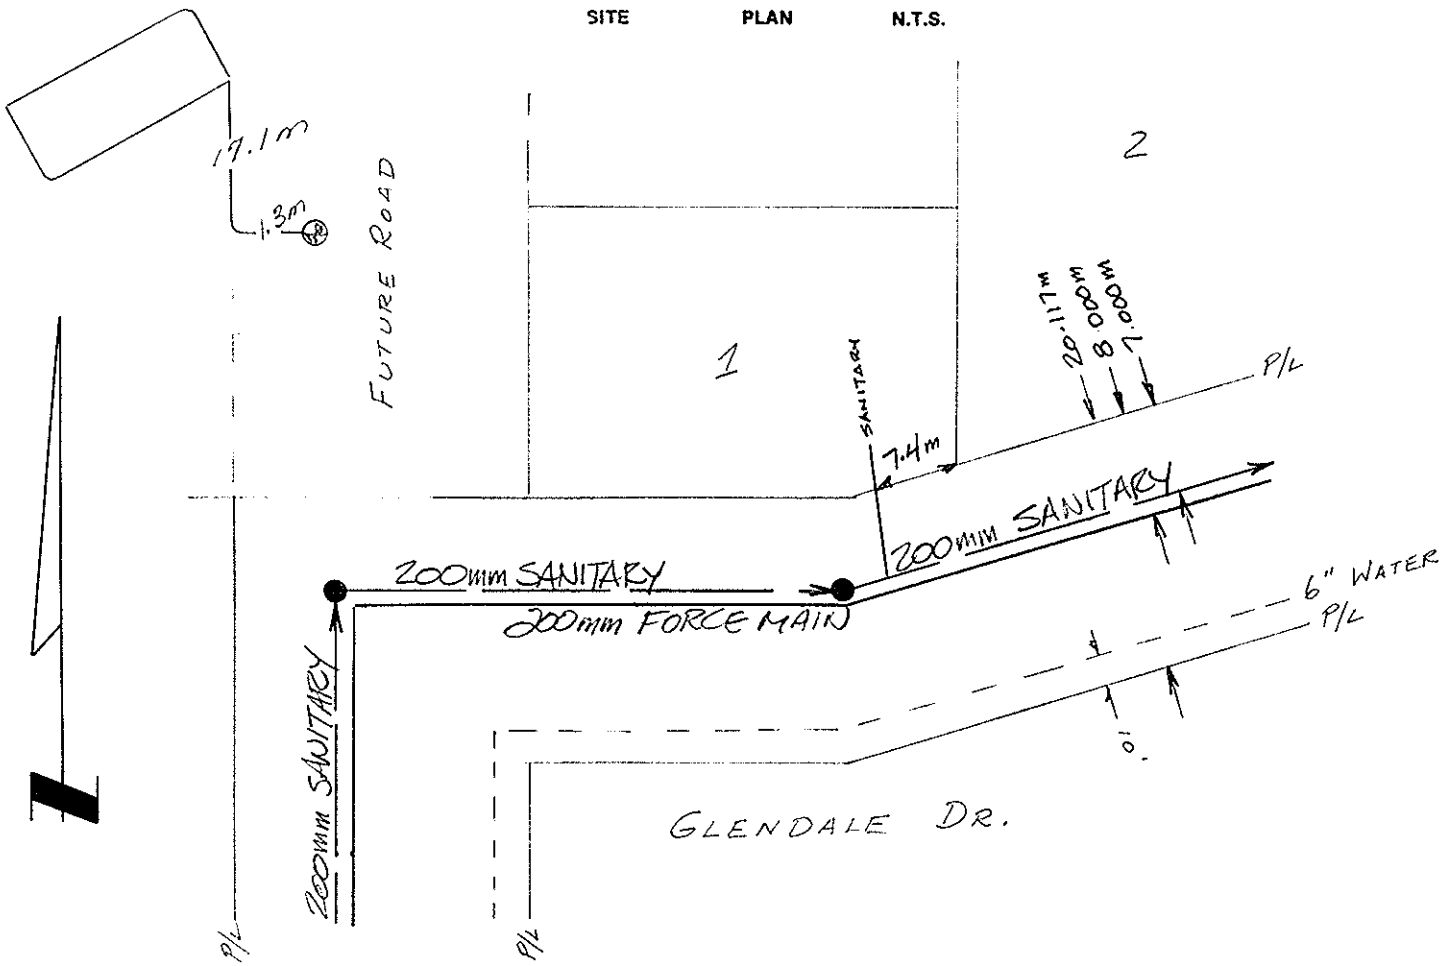
SITE PLAN N.T.S.