City of Prince George
HISTORY SHEET

011745916

SHEET NUMBER 6092 **Roll Number**

Legal: LOT'S 9 BLOCK D.L. 4047 PLAN 16575

Address: 3845 RUNDSTON ROAD 3842 RUNDSTON ROAD.

Sanitary Connection: # 13459 SIZE 100mm ø MATERIAL P.V.C. INV. 30.183. CONNECTED

Water Connection # SIZE 3/4 MATERIAL METER CONNECTED

Storm Connection: # SIZE MATERIAL INV. CONNECTED

Cash Receipt No's: WATER SANITARY 2656 STORM

CURB FROM PROPERTY LINE PAVEMENT WIDTH

B.C. HYDRO UNDERGROUND CONNECTION

B.C. TELEPHONE UNDERGROUND CONNECTION

INLAND GAS

Information Sheets: BENCH MARK # 1875. ELEVATION - 742.391.

Comments: H.S. SE CORNER OF DAFG & RUNDSTON.

OWNER: CHARTRAND Jean Paul & Paulette Marie 1-7-75
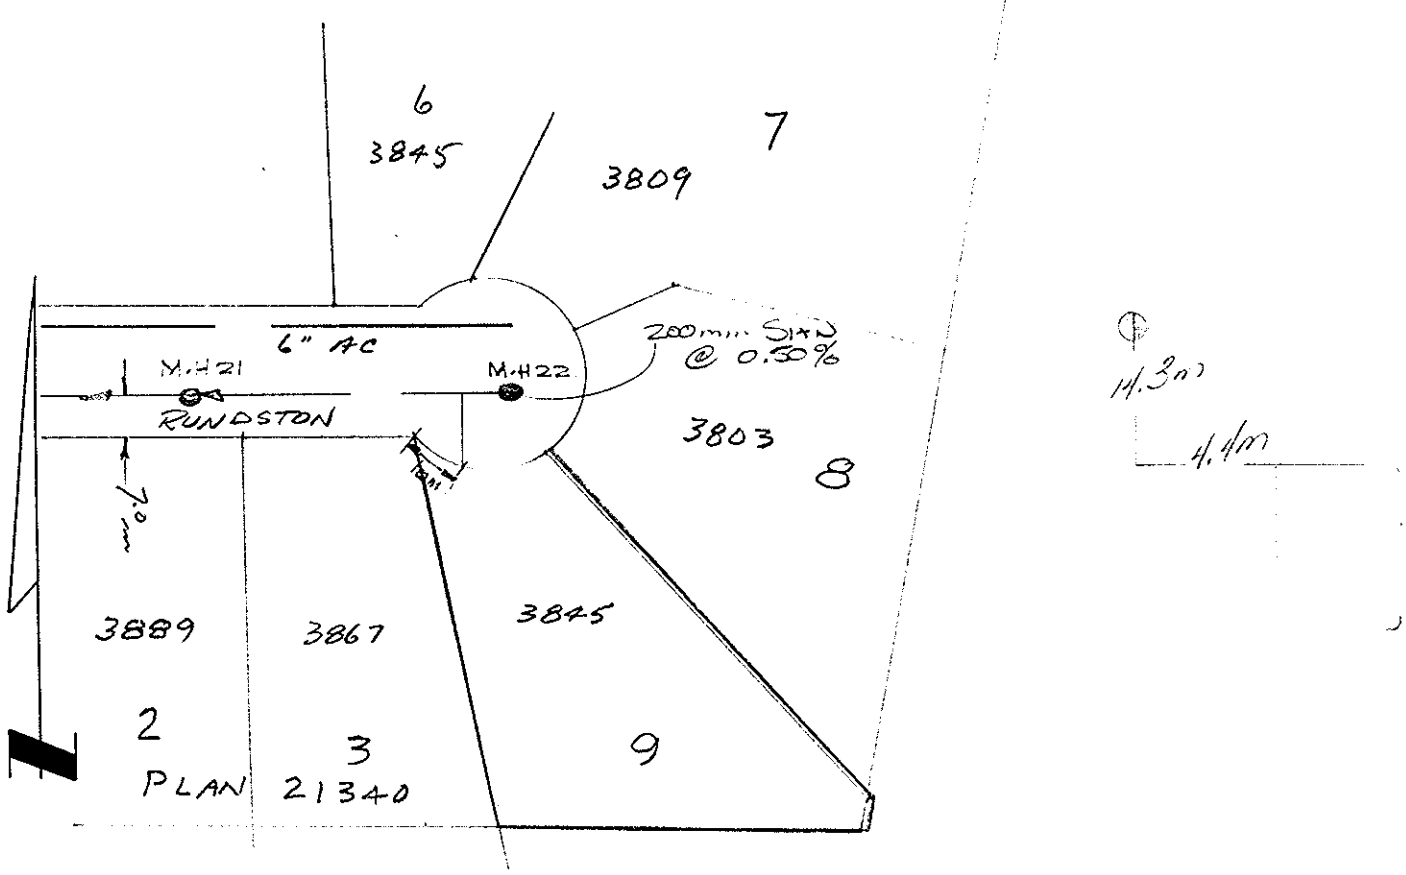
SITE PLAN N.T.S.