City of Prince George
HISTORY SHEET

SHEET NUMBER **PID #** 011 767901

Legal: LOT'S 87 BLOCK D.L. 913 PLAN 16 511

Address: 247 WATSON CRES.

Sanitary Connection: # 5743 SIZE 100 mm MATERIAL A.C. INV. 586.047 CONNECTED

Water Connection: # 5743 SIZE 20 mm MATERIAL CU METER CONNECTED

Storm Connection: # SIZE mm MATERIAL INV. CONNECTED

Cash Receipt No's: WATER SANITARY STORM

CURB FROM PROPERTY LINE 4.877 m PAVEMENT WIDTH 10.363 m

B.C. HYDRO U/G UNDERGROUND CONNECTION

B.C. TELEPHONE U/G UNDERGROUND CONNECTION

INLAND GAS 3.048 m FROM PL.

Information Sheets:

Comments: WITH THAW WIRE.
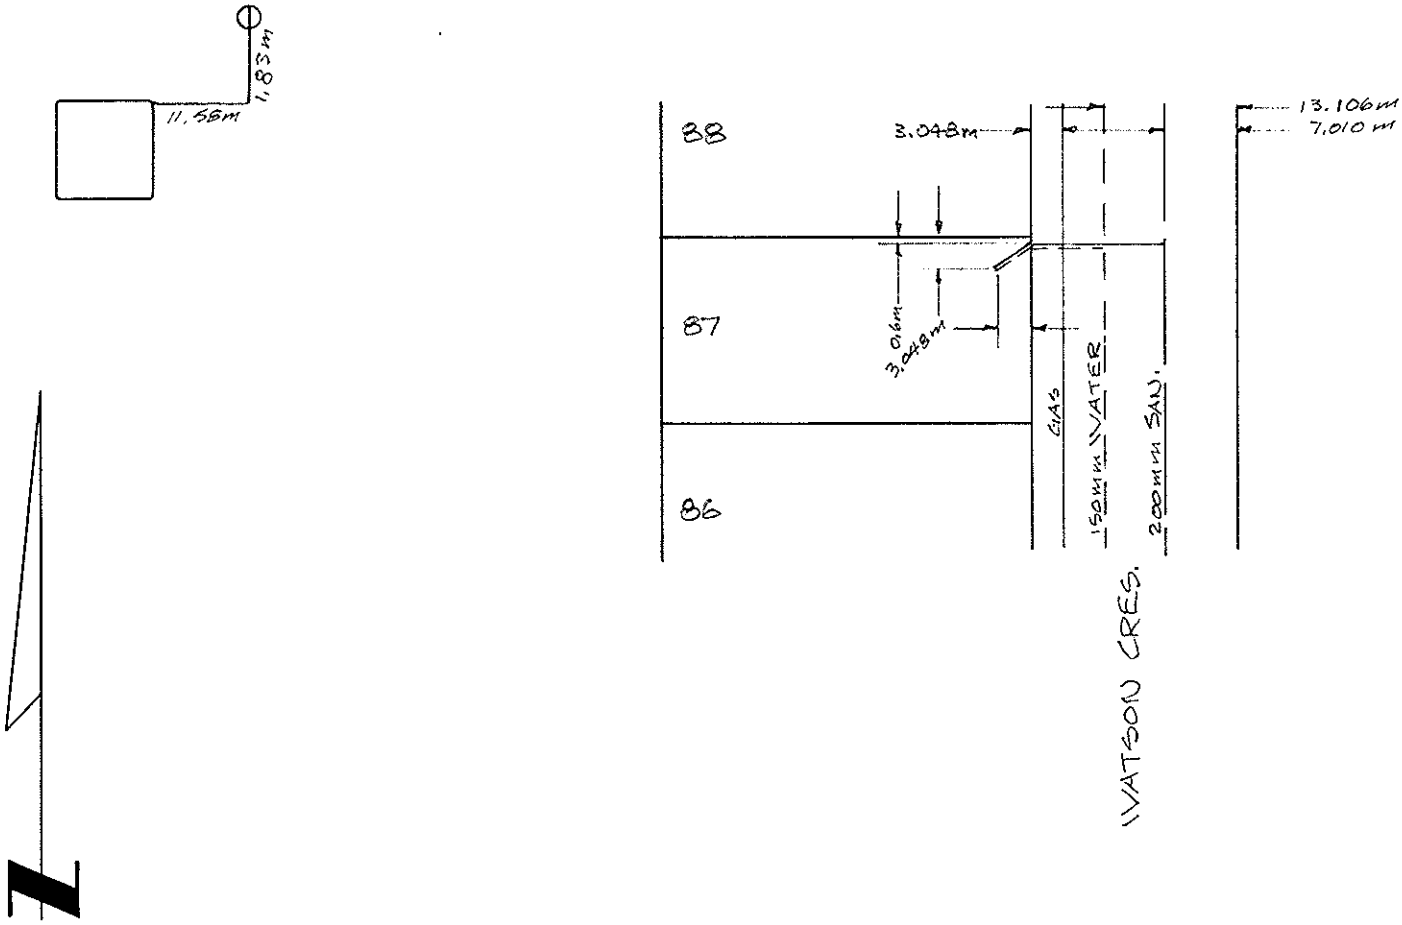
THE INFORMATION CONTAINED HEREIN IS FOR INTERNAL USE ONLY.
NOT TO BE RELIED UPON UNLESS CONFIRMED BY SITE INSPECTION AND/OR INVESTIGATION