011 72 123
158

City of Prince George
HISTORY SHEET

9

SHEET NUMBER **5258** **Roll Number**

Legal: LOT'S 13 & 14 BLOCK 346 D.L. 343 PLAN 1268

Address: 798 20th AVE.

Sanitary Connection: # 141 SIZE MATERIAL INV. 1886.44 CONNECTED

Water Connection # 808 SIZE 3/4" MATERIAL Cu METER CONNECTED

Storm Connection: # SIZE MATERIAL INV. CONNECTED

Cash Receipt No's: WATER SANITARY STORM

CURB FROM PROPERTY LINE PAVEMENT WIDTH

B.C. HYDRO O.H. UNDERGROUND CONNECTION

B.C. TELEPHONE O.H. UNDERGROUND CONNECTION

INLAND GAS AS SHOWN

Information Sheets:
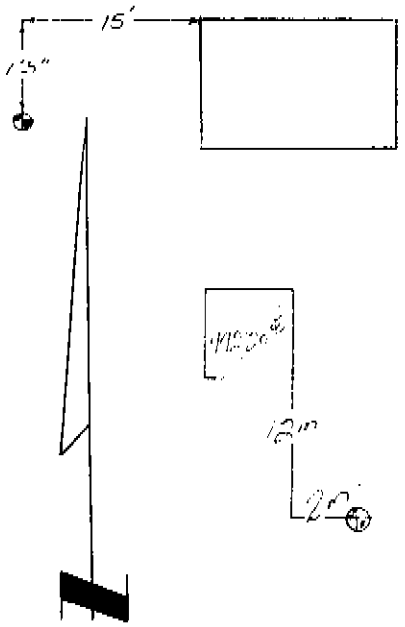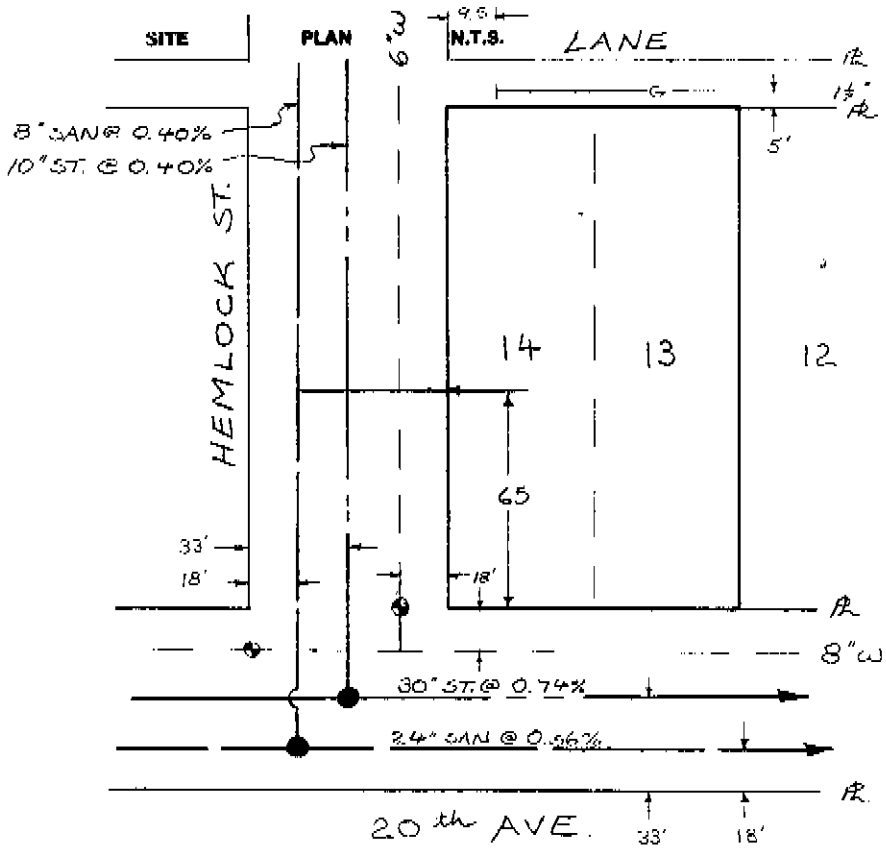
Comments: