011790067
011790075

City of Prince George
HISTORY SHEET

SHEET NUMBER № 2159 **Roll Number**

Legal: LOT'S 17, 18 BLOCK 331 D.L. 342 PLAN 1268

Address: 1942 UPLAND STREET

Sanitary Connection: # 7609 SIZE 4" MATERIAL A.C. INV. CONNECTED

Water Connection # 727 SIZE 3/4" MATERIAL METER CONNECTED

Storm Connection: # SIZE MATERIAL INV. CONNECTED

Cash Receipt No's: WATER SANITARY STORM

CURB FROM PROPERTY LINE PAVEMENT WIDTH

B.C. HYDRO UNDERGROUND CONNECTION

B.C. TELEPHONE UNDERGROUND CONNECTION

INLAND GAS

Information Sheets:

Comments:

THE INFORMATION CONTAINED HEREIN IS FOR INTERNAL USE ONLY. NOT TO BE RELIED UPON UNLESS CONFIRMED BY SITE INSPECTION AND/OR INVESTIGATION.
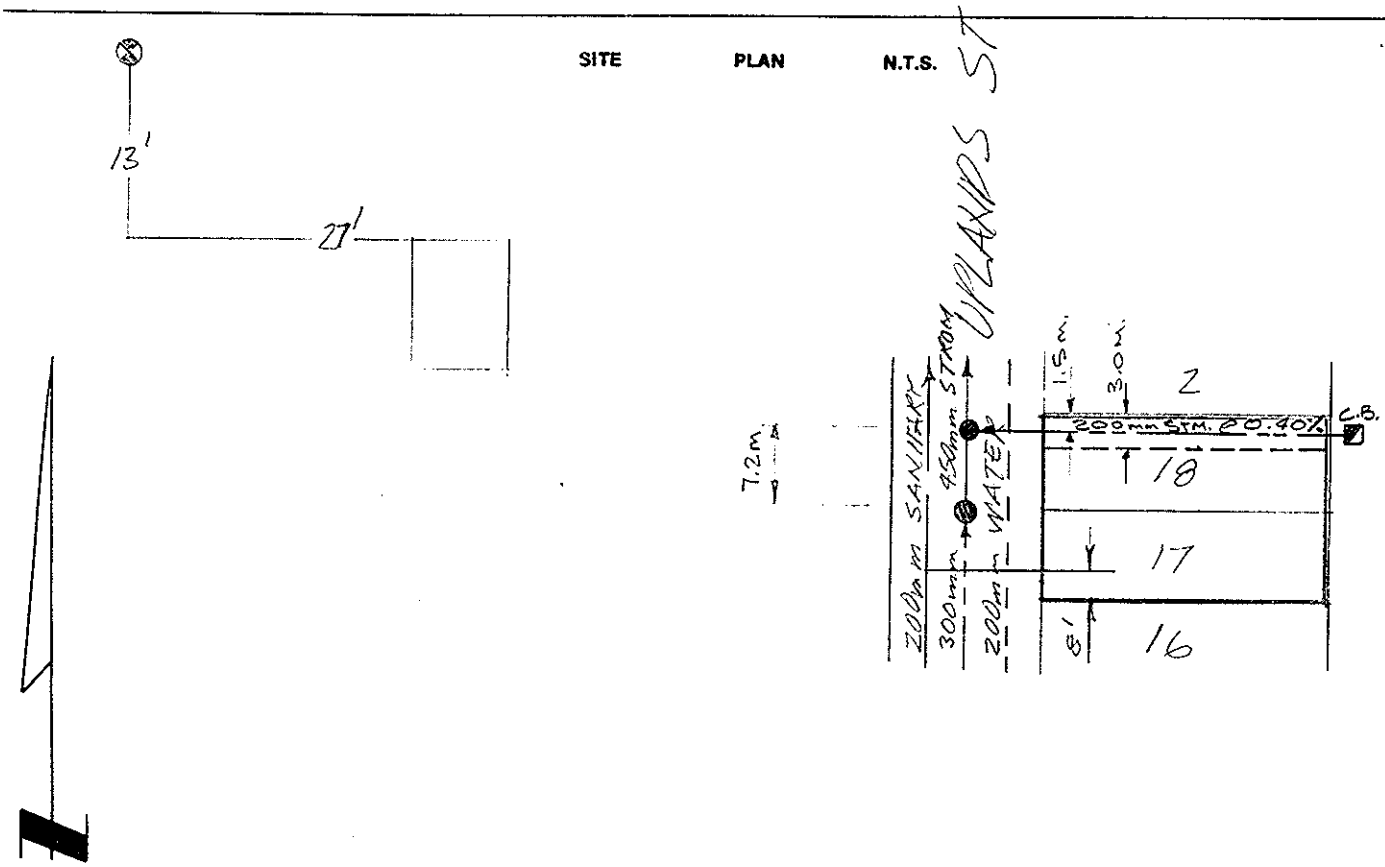
SITE PLAN N.T.S.