011795 3567

City of Prince George
HISTORY SHEET

SHEET NUMBER № 2139 **Roll Number**

Legal: LOT'S 16, 17 BLOCK 319 D.L. 343 PLAN 1268

Address: 1824 UPLANDS STREET

Sanitary Connection: # 3697 3325 ? SIZE MATERIAL INV. CONNECTED

Water Connection # 2354 3447 SIZE 3/4" MATERIAL COPPER METER CONNECTED

Storm Connection: # SIZE MATERIAL INV. CONNECTED

Cash Receipt No's: WATER SANITARY STORM

CURB FROM PROPERTY LINE PAVEMENT WIDTH

B.C. HYDRO UNDERGROUND CONNECTION

B.C. TELEPHONE UNDERGROUND CONNECTION

INLAND GAS

Information Sheets:

Comments:
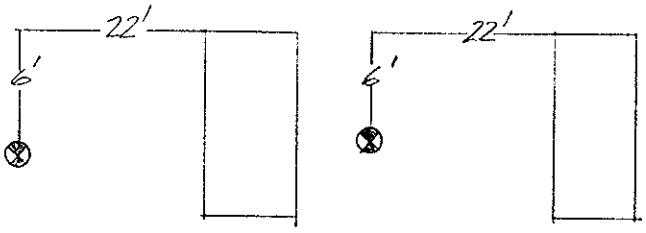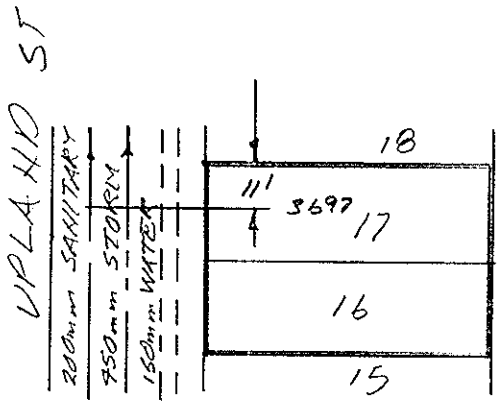
SITE PLAN N.T.S.