011796332
011796558

City of Prince George
HISTORY SHEET

SHEET NUMBER № 4076 **Roll Number** (SD 1105)

Legal: LOT'S D-1-2 BLOCK 320 D.L. 343 PLAN 1268 & C0178

Address: 1805 UPLAND ST.

Sanitary Connection: # 7580 SIZE 4" MATERIAL A.C. INV. CONNECTED

Water Connection # 7609 SIZE 1" MATERIAL CU METER CONNECTED

Storm Connection: # SIZE MATERIAL INV. CONNECTED

Cash Receipt No's: WATER SANITARY 56 STORM

CURB FROM PROPERTY LINE PAVEMENT WIDTH

B.C. HYDRO UNDERGROUND CONNECTION

B.C. TELEPHONE UNDERGROUND CONNECTION

INLAND GAS

Information Sheets:
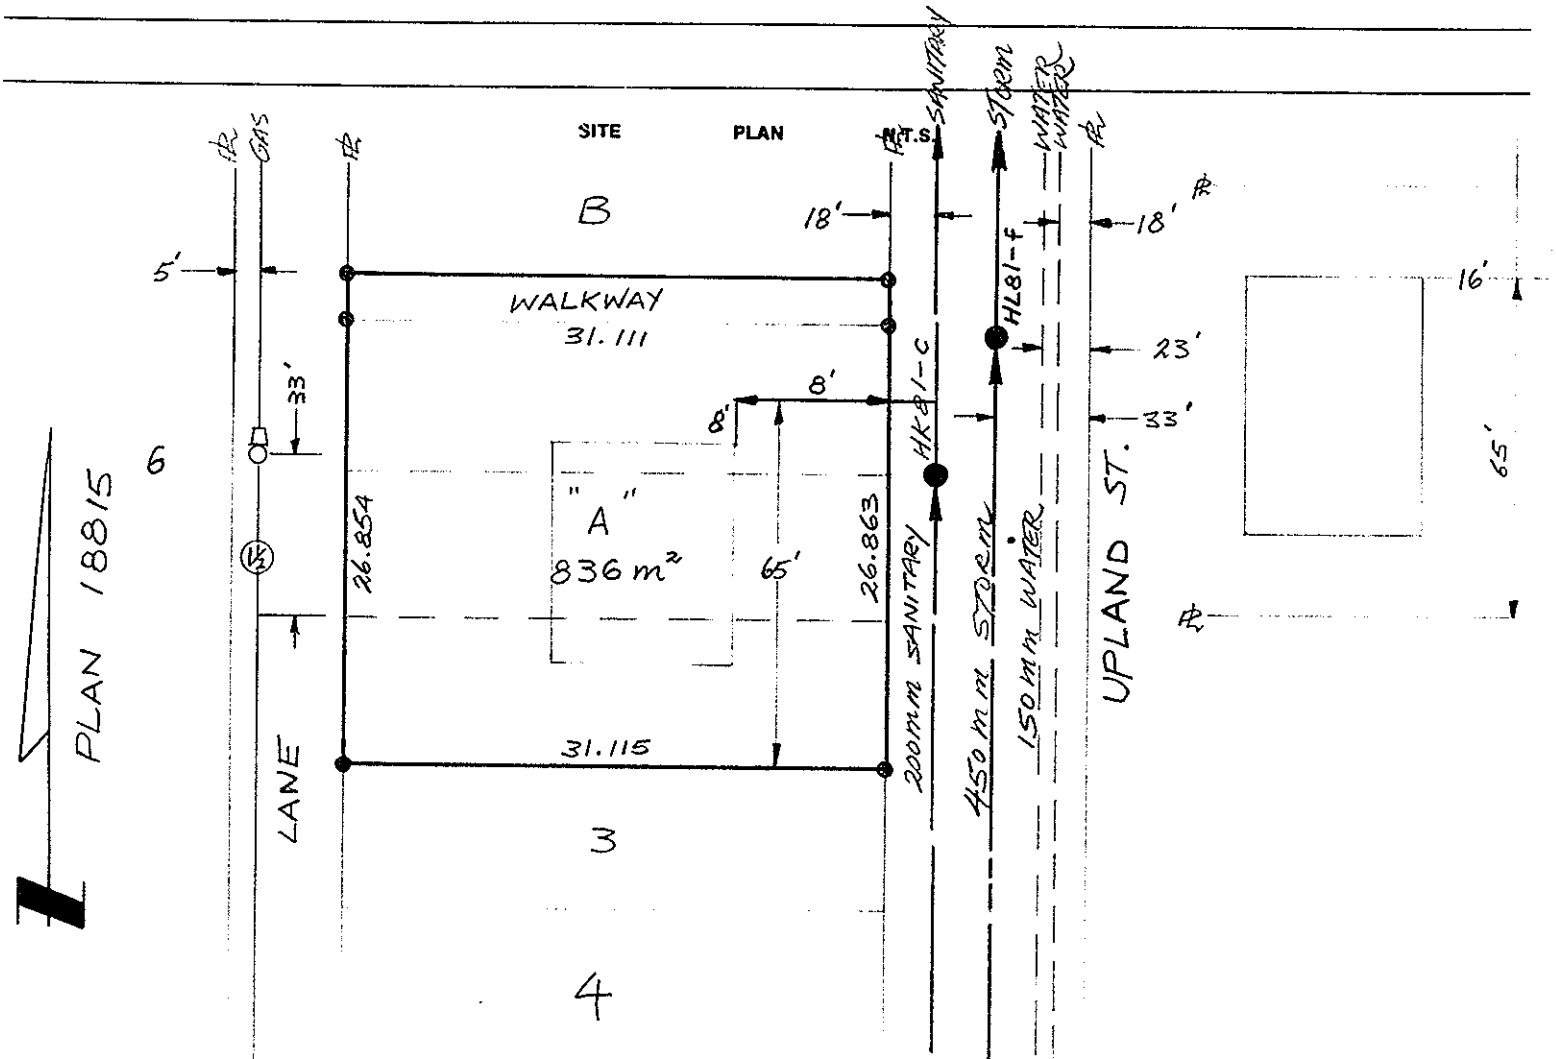
Comments: