011 801 379
395
S 425

City of Prince George
HISTORY SHEET

SHEET NUMBER 5203 Roll Number

Legal: LOT'S 13-15 BLOCK 293 D.L. 343 PLAN 1268

Address: 1752 GORSE ST.

Sanitary Connection: # 3921 SIZE MATERIAL INV. 1886.46 CONNECTED

Water Connection # 1853 SIZE ½" MATERIAL METER CONNECTED

Storm Connection: # SIZE MATERIAL INV. CONNECTED

Cash Receipt No's: WATER SANITARY STORM

CURB FROM PROPERTY LINE PAVEMENT WIDTH

B.C. HYDRO O.H UNDERGROUND CONNECTION

B.C. TELEPHONE O.H. UNDERGROUND CONNECTION

INLAND GAS AS SHOWN

Information Sheets:

Comments: THE INFORMATION CONTAINED HEREIN IS FOR INTERNAL USE ONLY. NOT TO BE RELIED UPON UNLESS CONFIRMED BY SITE INSPECTION AND/OR INVESTIGATION.

WATER: DUAL ON S P/L FOR 13

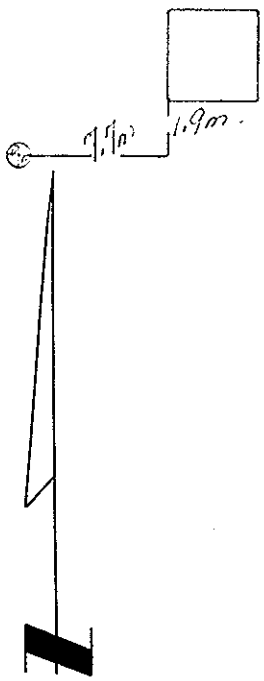
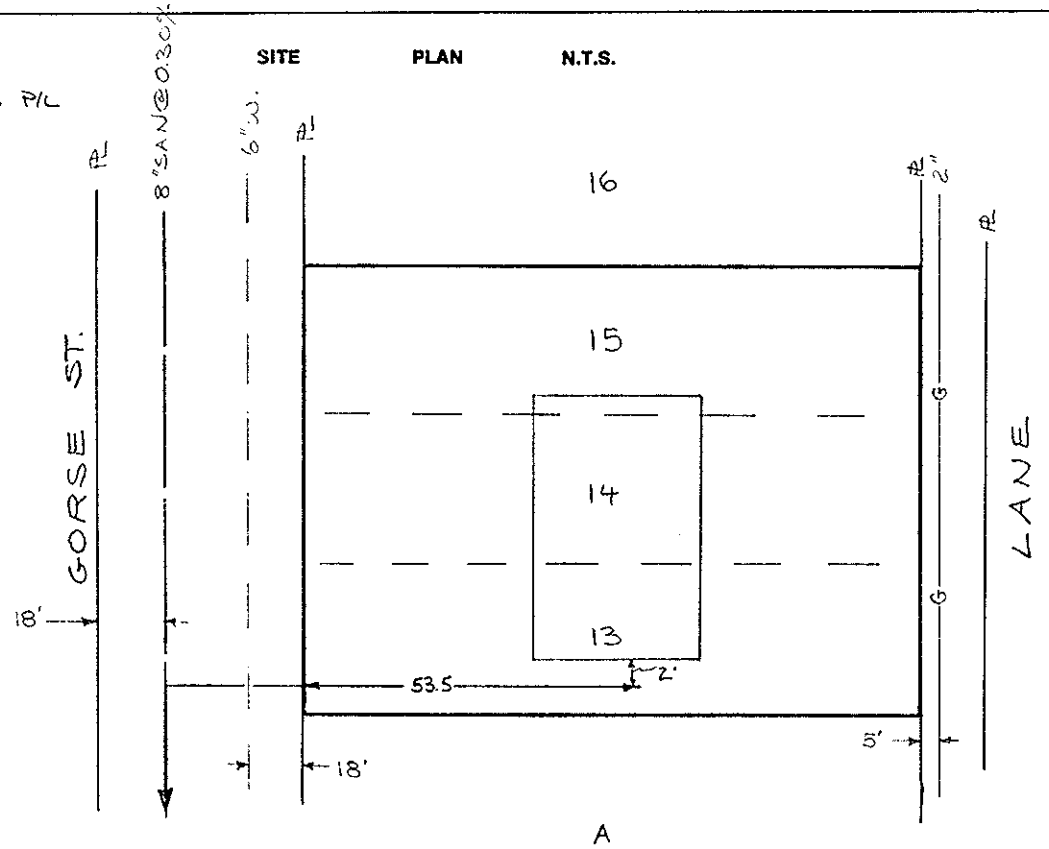
SITE PLAN N.T.S.