City of Prince George
HISTORY SHEET

01182137 0
01182138 8

SHEET NUMBER № 2212 **Roll Number**

Legal: LOT'S 18-19 BLOCK 318 D.L. 343 PLAN 1268

Address: 1818, 1822 TAMARACK STREET

Sanitary Connection: # 7505 7614 SIZE 4" MATERIAL A.C. INV. CONNECTED

Water Connection # 2241 SIZE 3/4" MATERIAL COPPER METER CONNECTED

Storm Connection: # SIZE MATERIAL INV. CONNECTED

Cash Receipt No's: WATER SANITARY 7614-74 STORM

CURB FROM PROPERTY LINE PAVEMENT WIDTH

B.C. HYDRO UNDERGROUND CONNECTION

B.C. TELEPHONE UNDERGROUND CONNECTION

INLAND GAS

Information Sheets:

Comments:
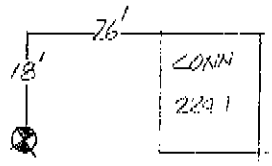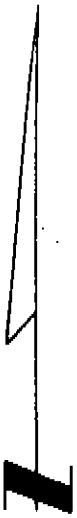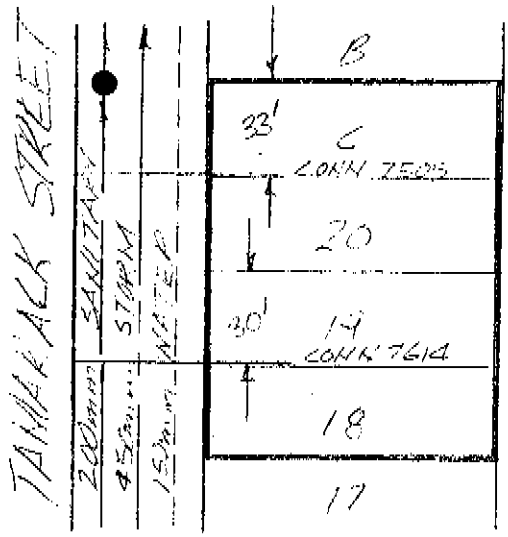
SITE PLAN N.T.S.