011824531
549

City of Prince George
HISTORY SHEET

SHEET NUMBER **5314** **Roll Number**

Legal: LOT'S 3-4 BLOCK 305 D.L. 343 PLAN 1268

Address: 1827 HEMLOCK ST.

Sanitary Connection: # 401 SIZE MATERIAL INV. 1884.86 CONNECTED

Water Connection # 2310 SIZE 3/4" MATERIAL Cu METER CONNECTED

Storm Connection: # SIZE MATERIAL INV. CONNECTED

Cash Receipt No's: WATER SANITARY STORM

CURB FROM PROPERTY LINE PAVEMENT WIDTH

B.C. HYDRO O.H. UNDERGROUND CONNECTION

B.C. TELEPHONE O.H. UNDERGROUND CONNECTION

INLAND GAS AS SHOWN

Information Sheets:

Comments: TO THAW WATER PIPE HOOK TO 1825 HEMLOCK.
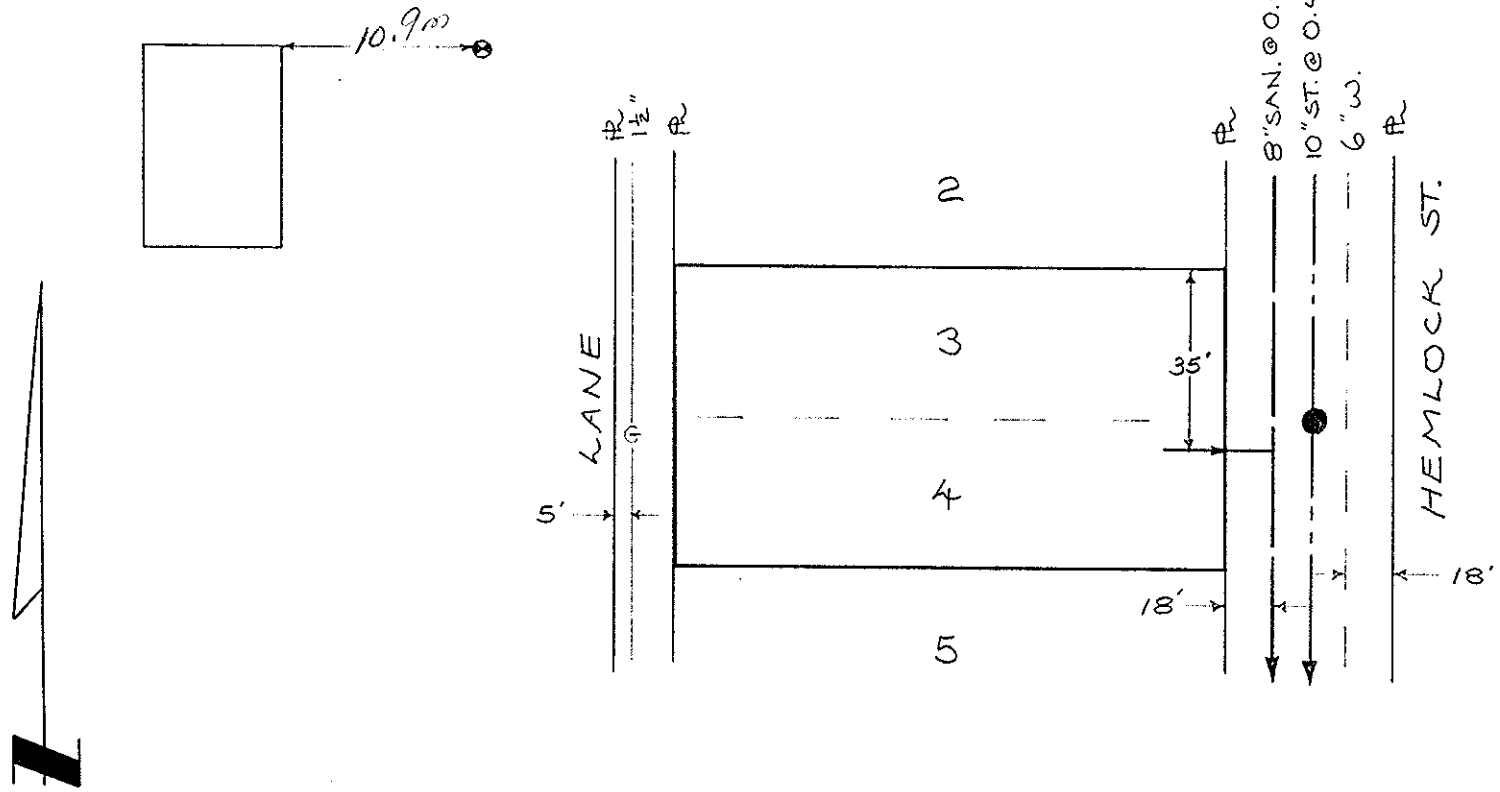
SITE PLAN N.T.S.